


T.5S., R.7W., W.M.

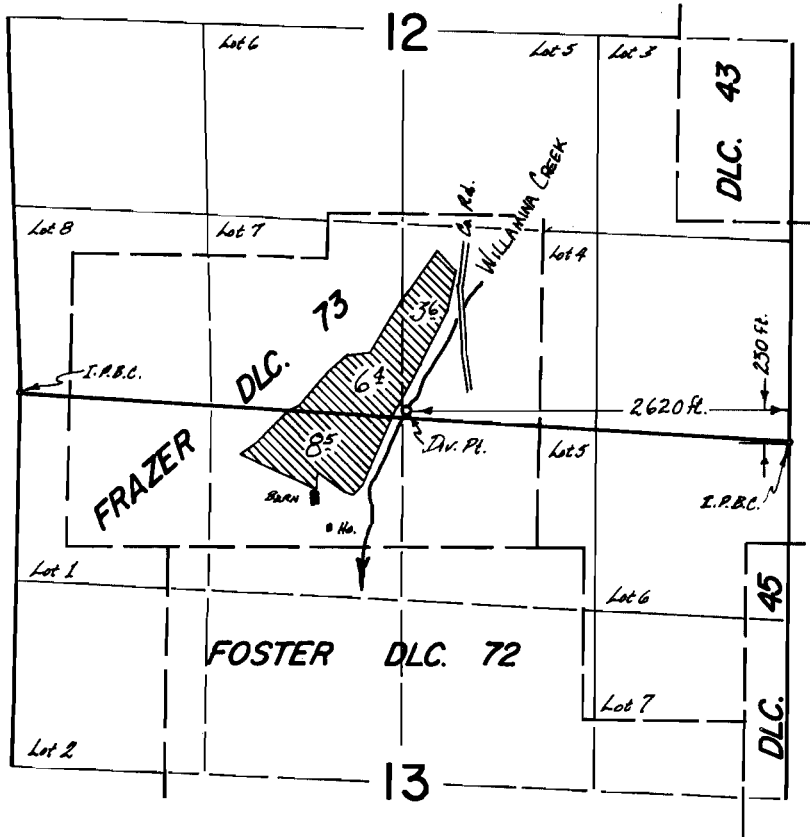

**FINAL PROOF SURVEY**  
UNDER

Application No. 43842 Permit No. 32805  
IN NAME OF

RICHARD W. SWANSON

Surveyed 5 JULY 1972, by D. NOBIS