


T.4S., R.3W., W.M.

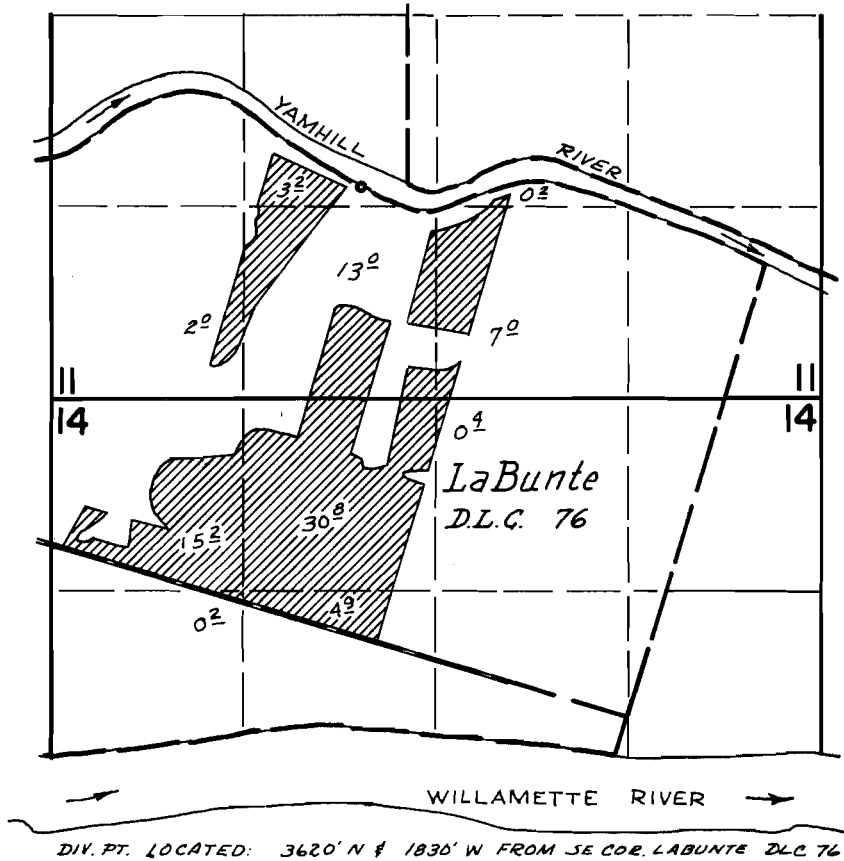

FINAL PROOF SURVEY UNDER

Application No. 44202 Permit No. 33024
IN NAME OF

JOE OWENS OR GARY OWENS

Surveyed Oct. 25 1972 by D. Norby