


T.5S., R.5W., W.M.

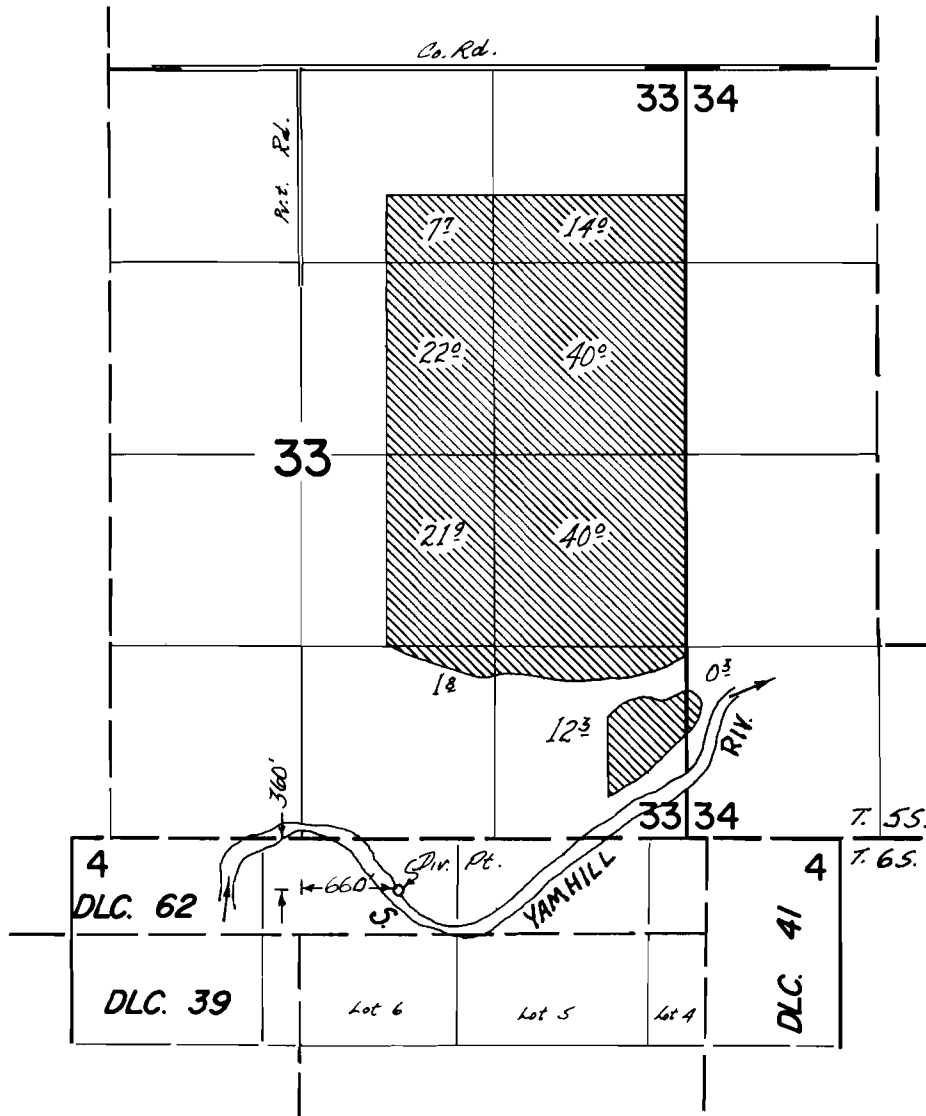

**FINAL PROOF SURVEY**  
UNDER

Application No. 46275 Permit No. 34258  
IN NAME OF  
**JOHN DeJONG**

Surveyed 13 Nov. 1972 by D NORBY