


T.5S., R.7W., W.M.

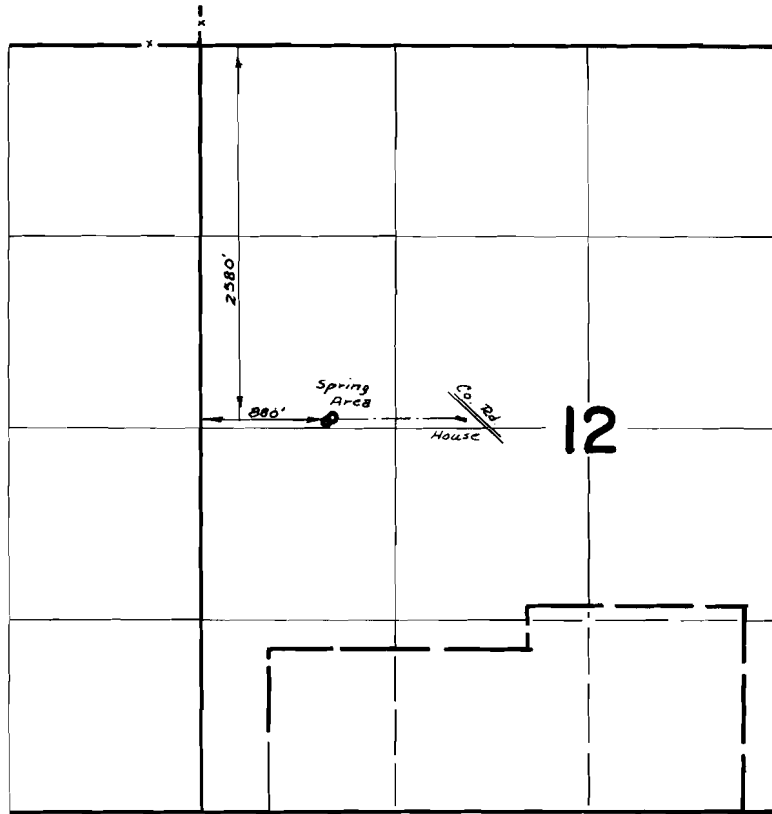

**FINAL PROOF SURVEY**  
UNDER

Application No. 45906 Permit No. 34294  
IN NAME OF

CLIFFORD C. DADE

Surveyed July 6 1972, by D. Norby