


T.5S., R.5W., W.M.

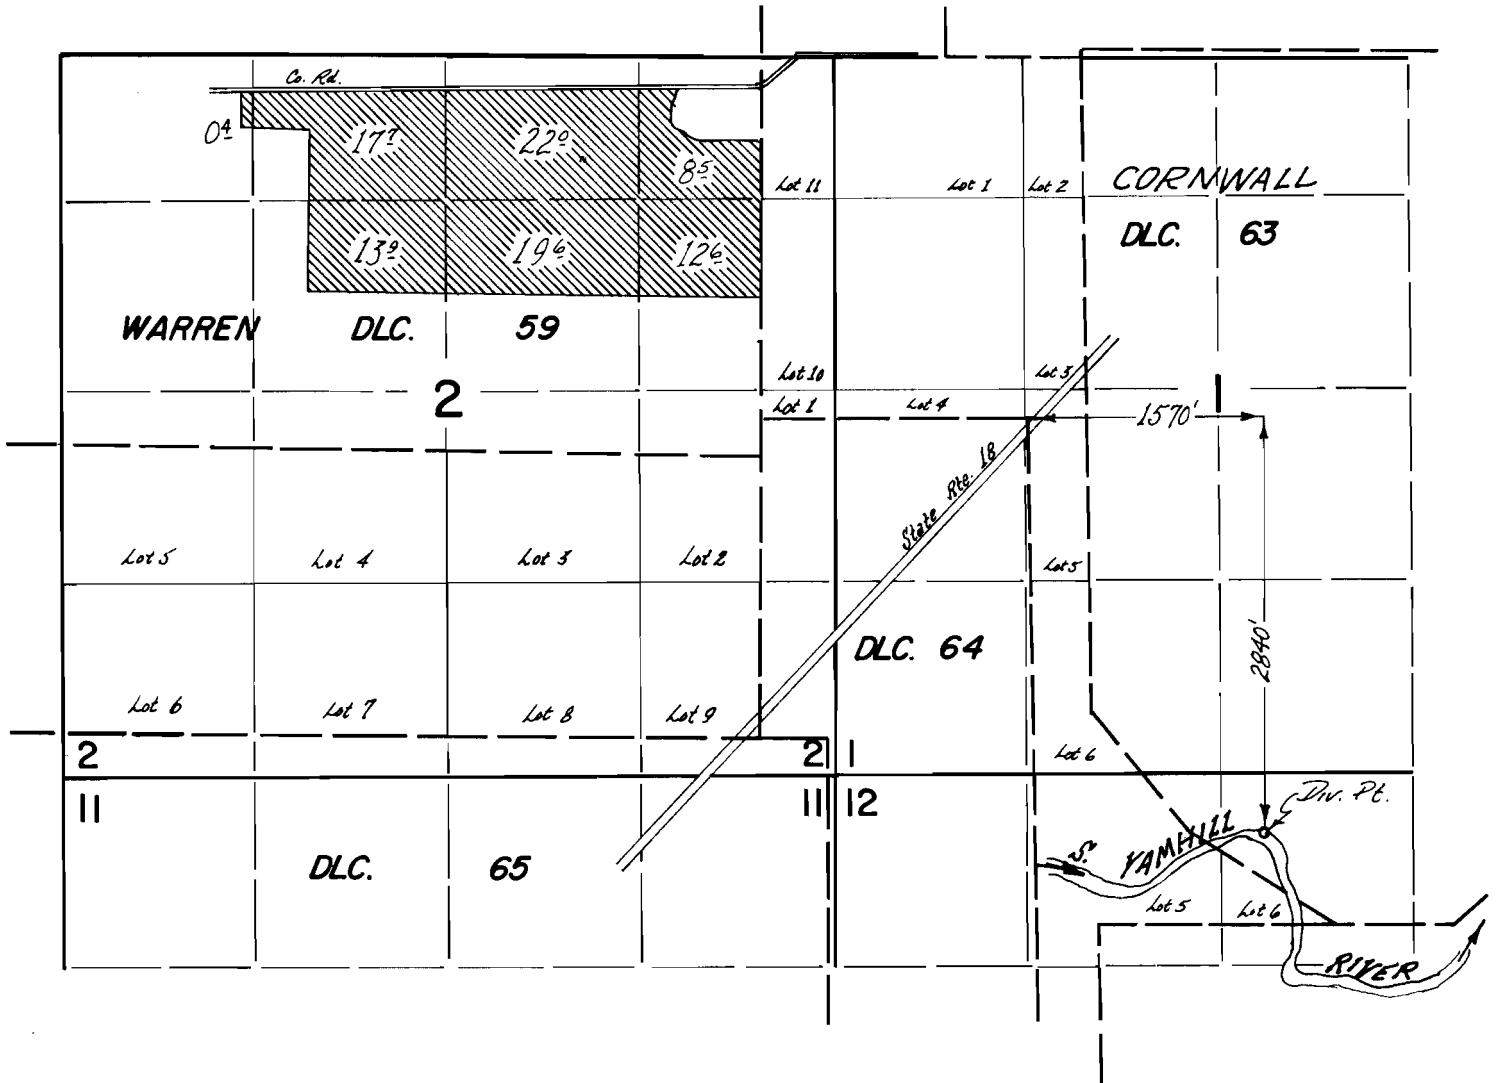

**FINAL PROOF SURVEY**  
UNDER

Application No. 45969 Permit No. 34335  
IN NAME OF

MARVIN BERNARDS

Surveyed 14 Nov. 1972 by D. NORBY