


T.5S., R.3W., W.M.

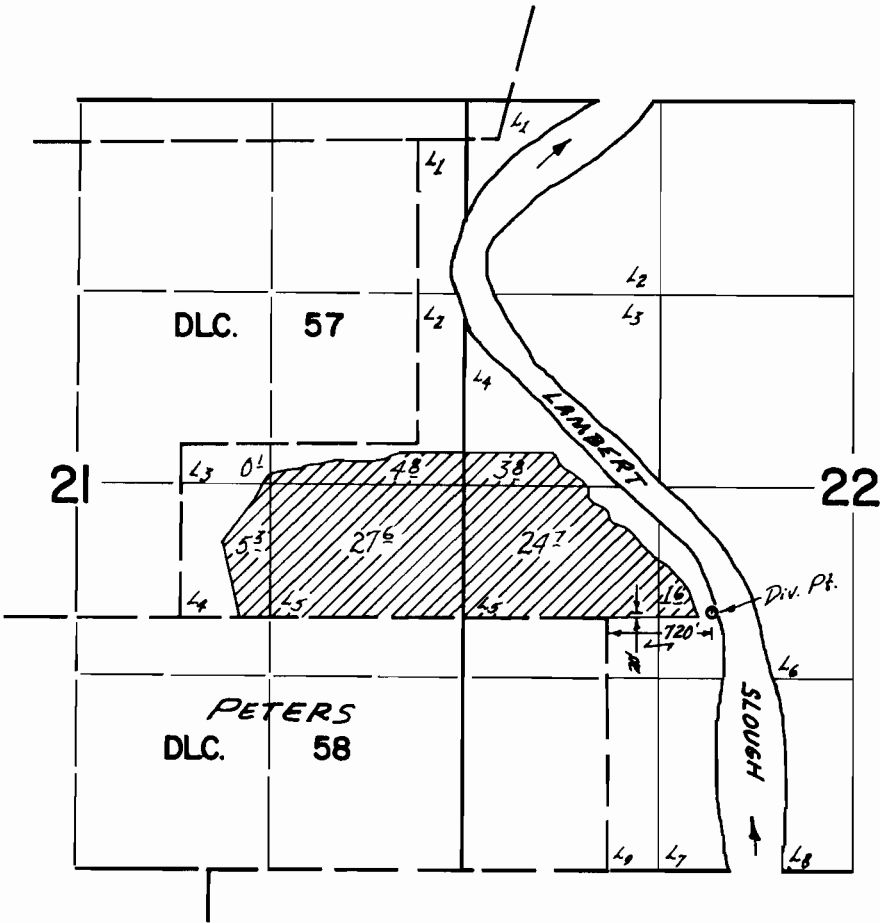

FINAL PROOF SURVEY
UNDER

Application No. 46574 Permit No. 34807
IN NAME OF

EDITH LORRAINE YUNGEN

Surveyed 8 Nov. 1972, by D. NORBY