T. 5 S., R. 4 W., W.M.

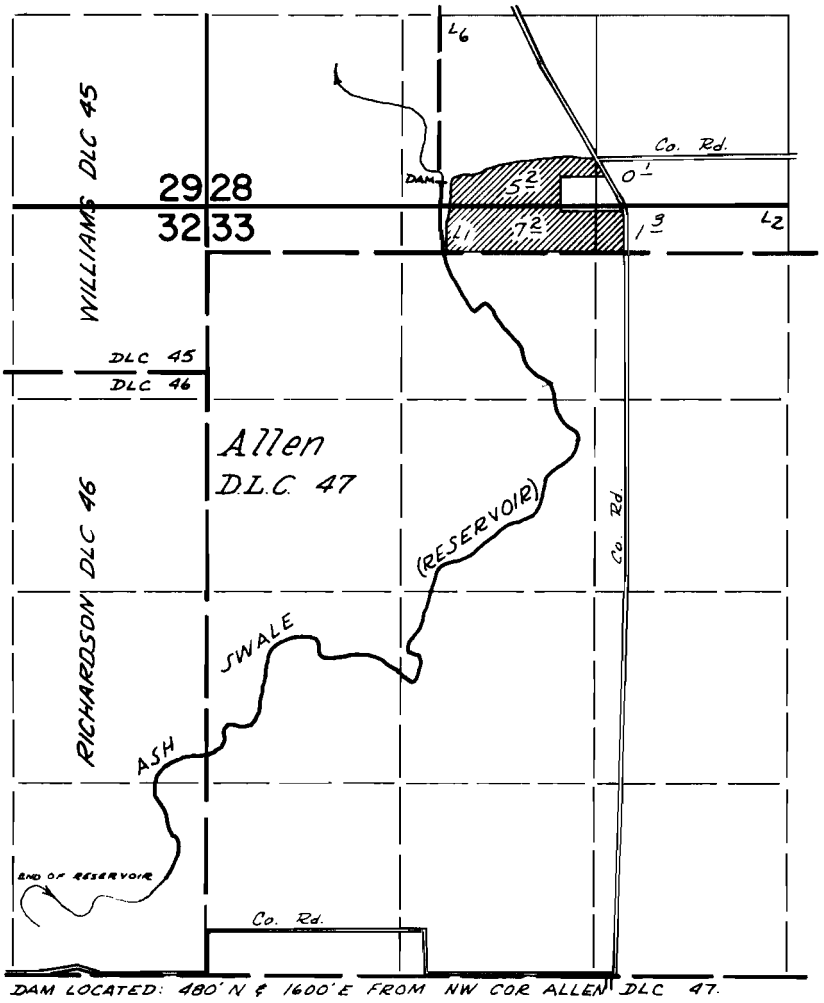

FINAL PROOF SURVEY
UNDER

Application No. R-47551 (47317) Permit No. R-5593 (34939)
IN NAME OF

WARREN L. VANDERHOOF

Surveyed May 18 19 72, by D. Norby

DFQ - ILL - 117