


T.5S., R.5W., W.M.

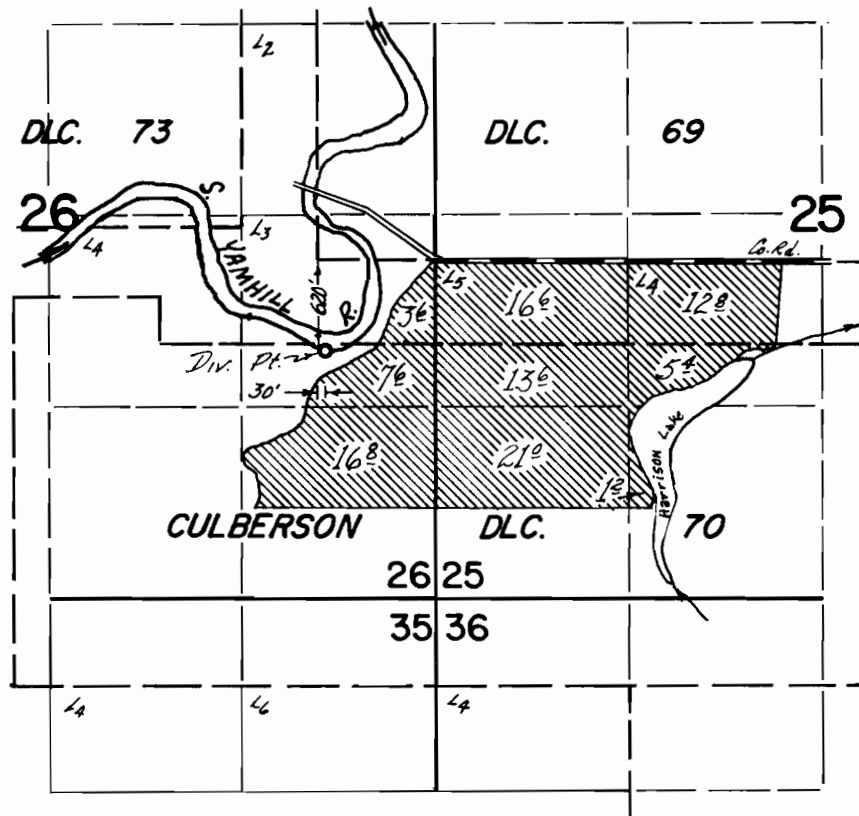

**FINAL PROOF SURVEY**  
UNDER

Application No. 46878 Permit No. 35047  
IN NAME OF

NORVAL GOFFENA

Surveyed 27 JULY 1972, by D. NORBY