


T.5S., R.3W., W.M.

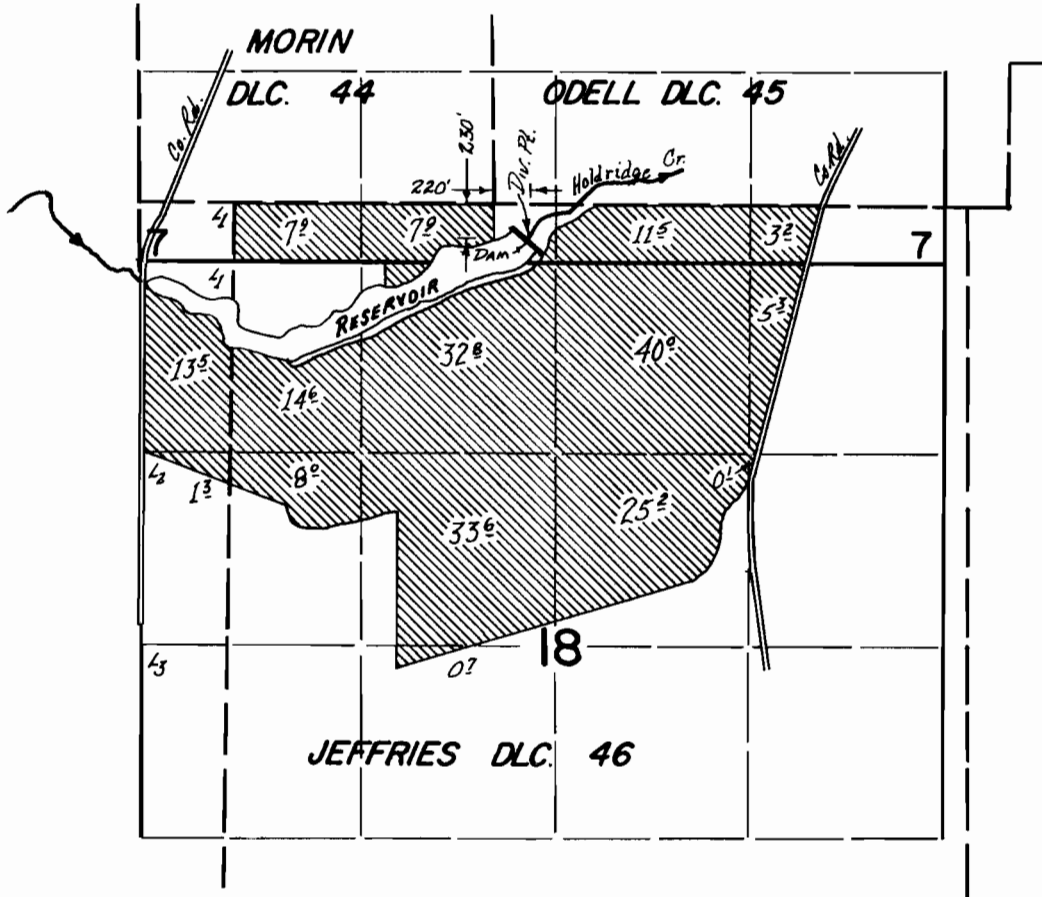

FINAL PROOF SURVEY
UNDER

R-45141 R-5153
Application No. 45142 Permit No. 33206
IN NAME OF

PHILLIP & LAVANNE EICHLER

Surveyed 9 Nov. 1972, by D. NORBY