


T.5S., R 3W., W.M.

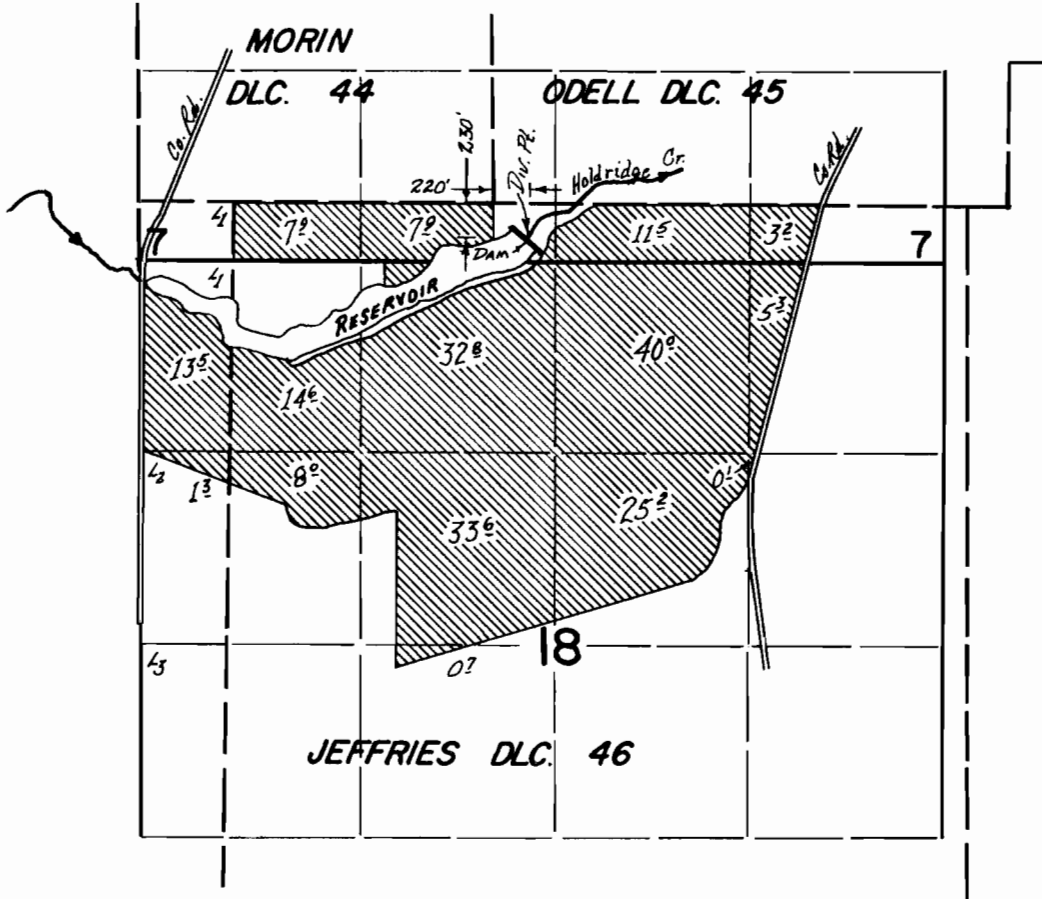

**FINAL PROOF SURVEY**  
UNDER

R-45141                      R-5153  
Application No. 45142    Permit No. 33206  
IN NAME OF

PHILLIP & LAVANNE EICHLER

Surveyed 9 Nov. 1972, by D. NORBY