T. 5 S., R. 5 W., W.M.

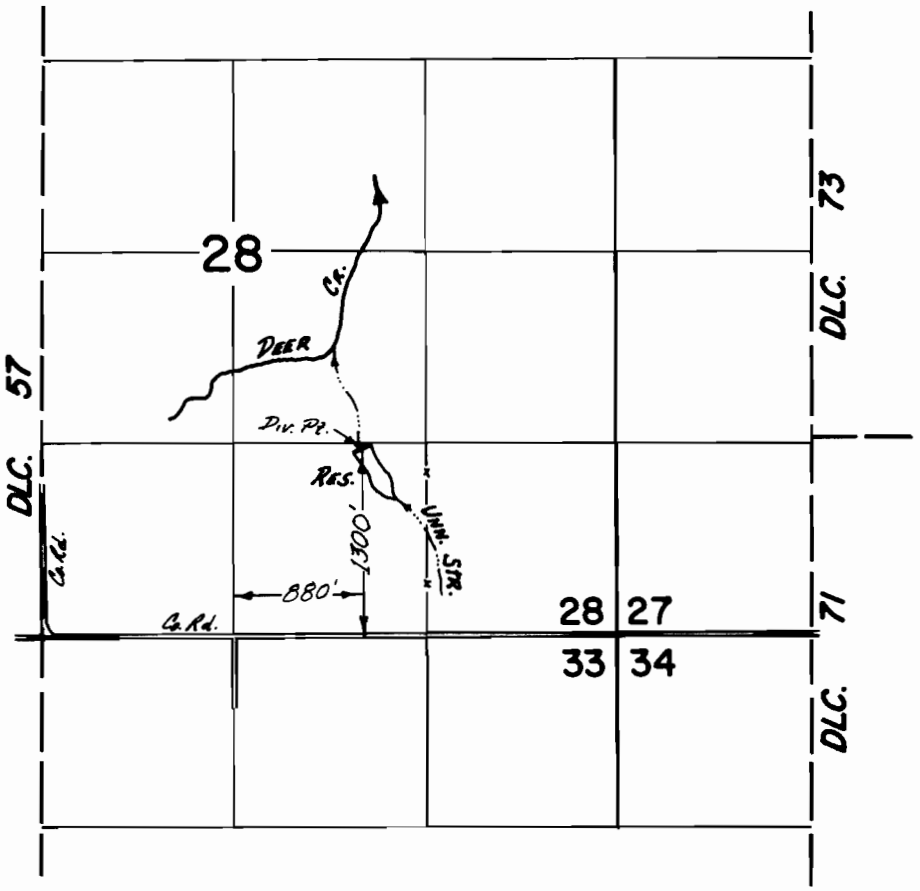

FINAL PROOF SURVEY
UNDER

R-44716 R-5154
Application No. 44717 Permit No. 33207
IN NAME OF

THEODORE B. & FRANCES D. ROSSNER

Surveyed 26 July 19 72, by D. Norby

DFR-ILL-52 f 1972 B