


T.5S.,R.5W.,W.M.

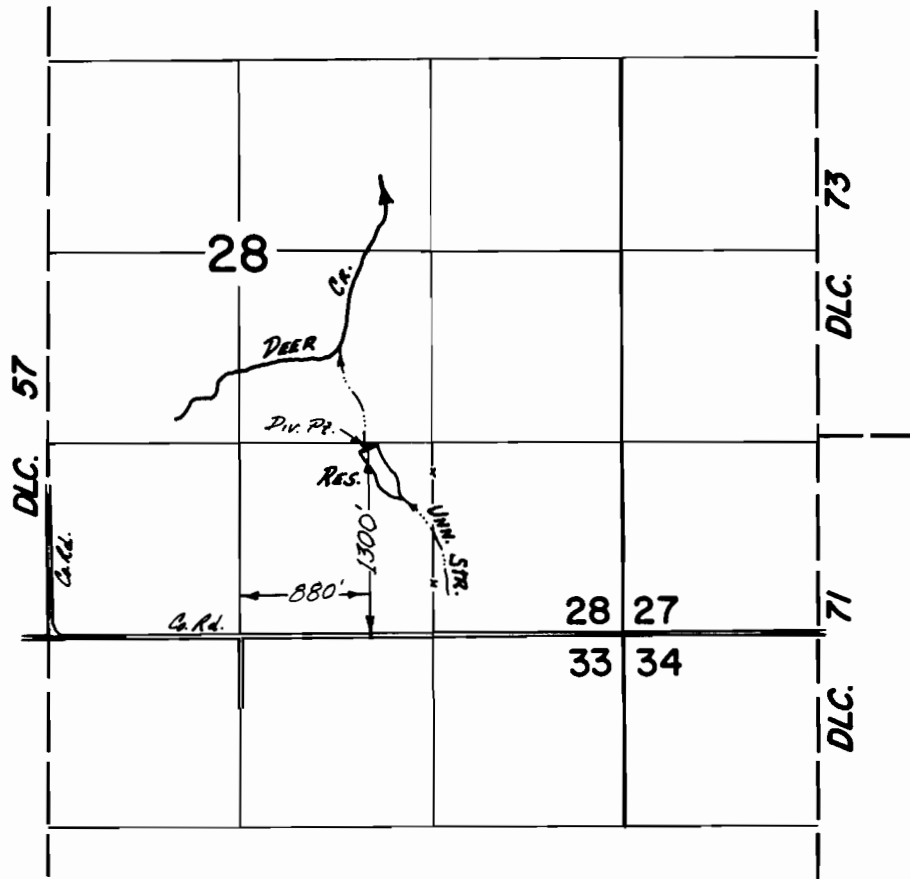

FINAL PROOF SURVEY
UNDER

R-44716 R-5154
Application No. 44717 Permit No. 33207
IN NAME OF

THEODORE B. & FRANCES D. ROSSNER

Surveyed 26 July 1972, by D. NORBY