


T.5 S., R.4 W., W.M.

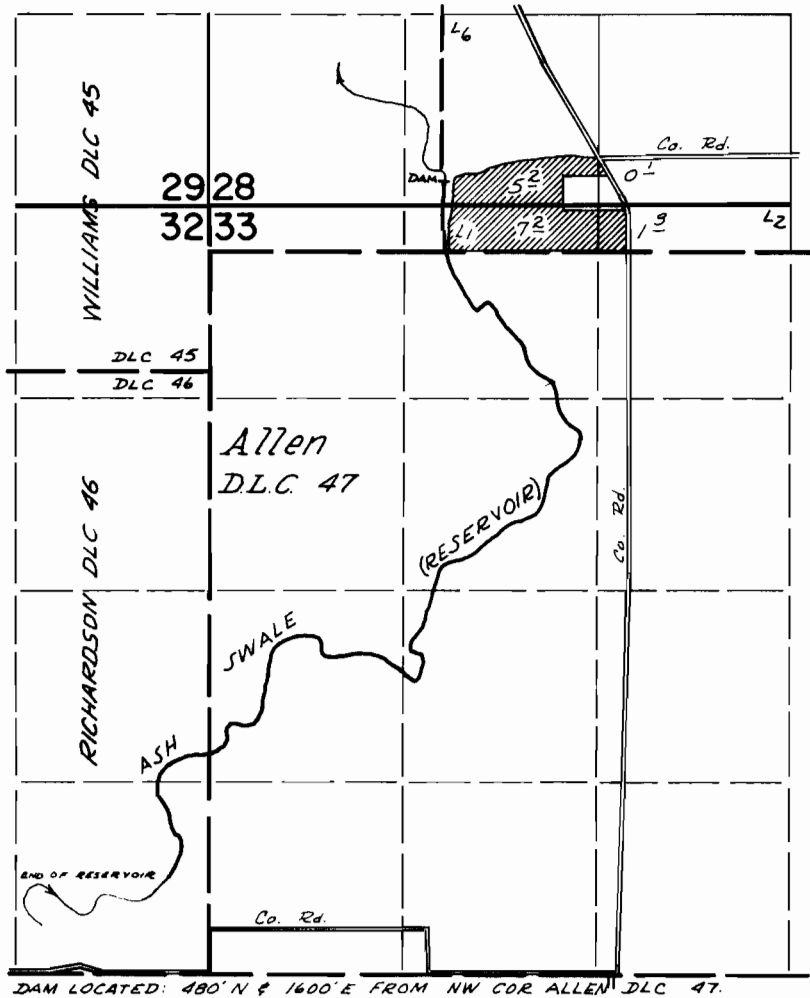

FINAL PROOF SURVEY UNDER

Application No. 47317 R-47551 Permit No. 34939 R-5593
IN NAME OF

WARREN L. VANDERHOOF

Surveyed May 18 19 72, by D. Norby