


T.26S. R.1W. W.M.

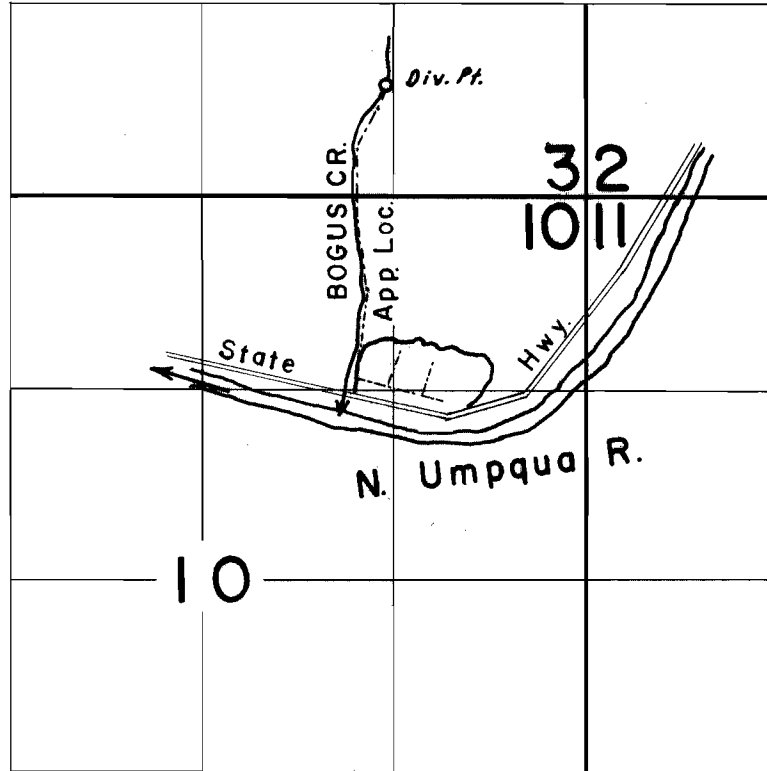

FINAL PROOF SURVEY
UNDER

Application No. 37148 Permit No. 27710
IN NAME OF

U.S. DEPARTMENT OF AGRICULTURE

Surveyed July 29, 1964, by C. J. Harder