


T.18S.R.2W.W.M.

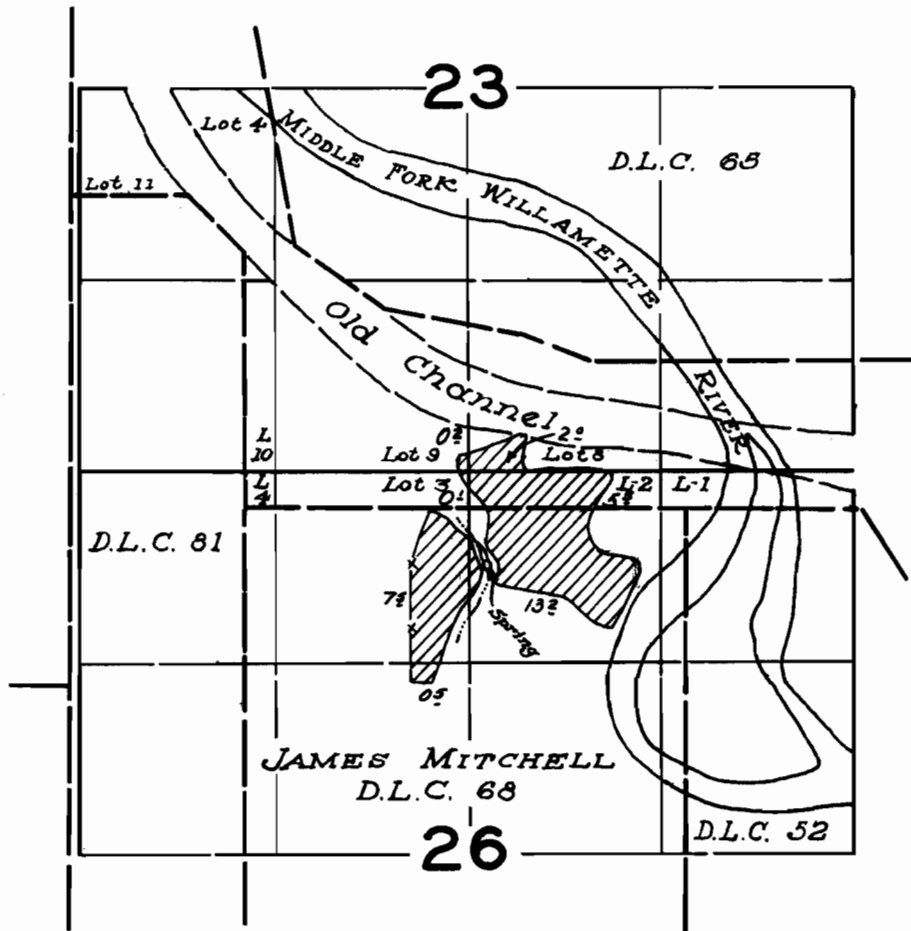

FINAL PROOF SURVEY
UNDER

Application No. 32830... Permit No. 25910...
IN NAME OF

L. W. TENNIS

Surveyed May 4... 1960, by *R. Jackson*