


T. IN. R. 3 W. W. M.

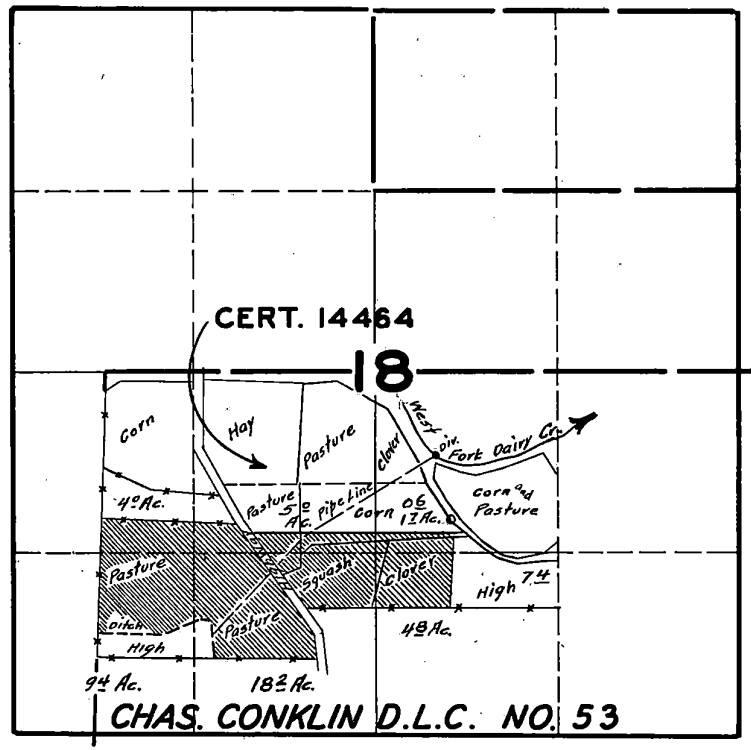

**FINAL PROOF SURVEY**  
UNDER

Application No. 18945 Permit No. 14595

IN NAME OF

ALBERT J. EVERS

Surveyed AUG. 28 1946, by