


T. 5S. R. 6W. W.M.

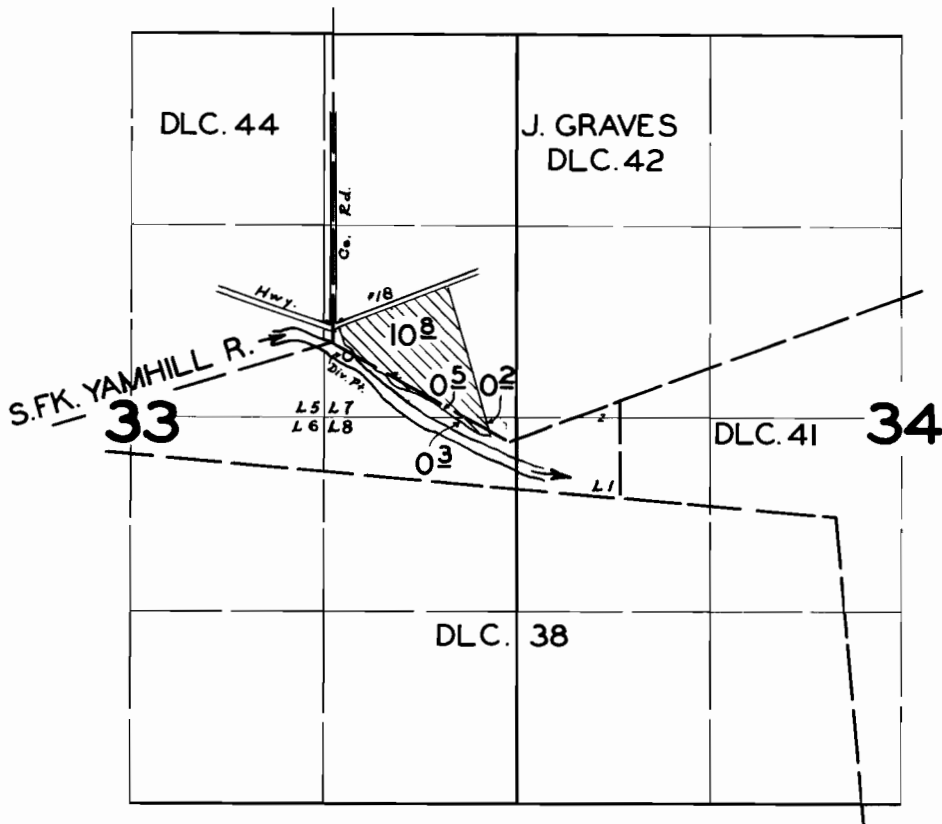

FINAL PROOF SURVEY
UNDER

Application No. 29049 Permit No. 22850
IN NAME OF

JOHN R. UMFRED

Surveyed APR. 10 1958 by M. BISH