


T.5 S.R.4 W.W.M.

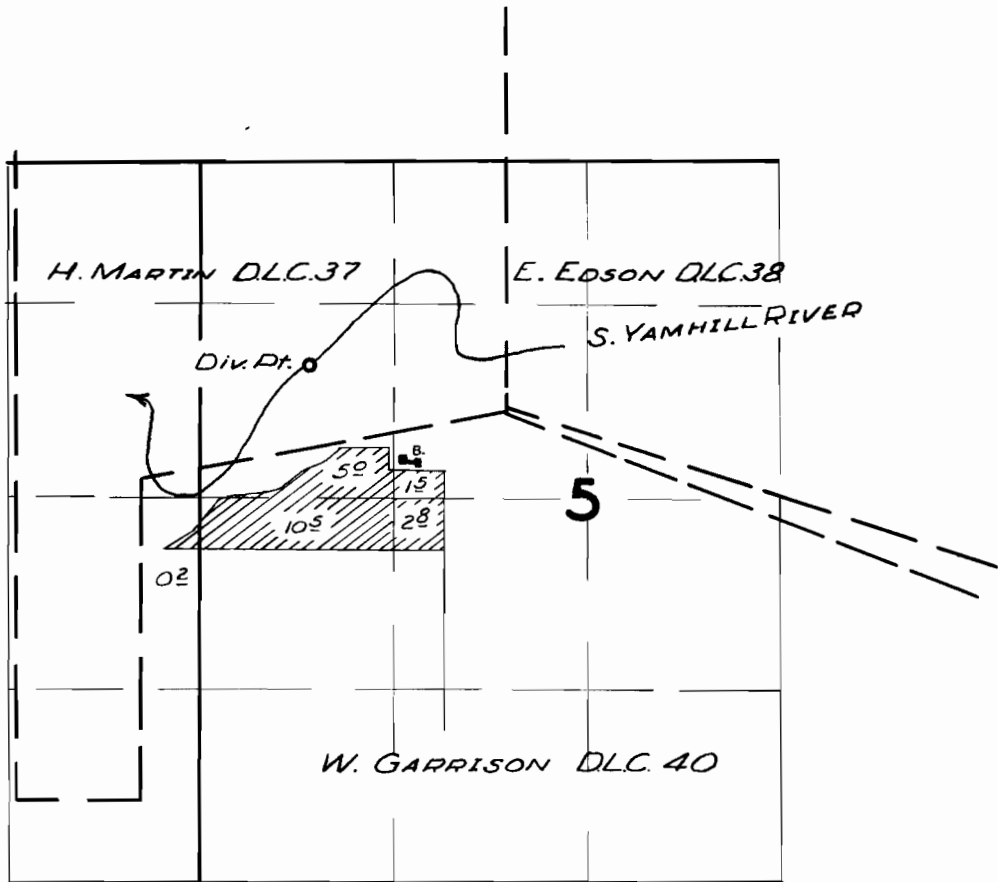

FINAL PROOF SURVEY UNDER

Application No. 32440. Permit No. 25607.
IN NAME OF

M. Swartzentruber

Surveyed 16 May 1960, by *Tom Bish*