


T.5S.R.4W.W.M.

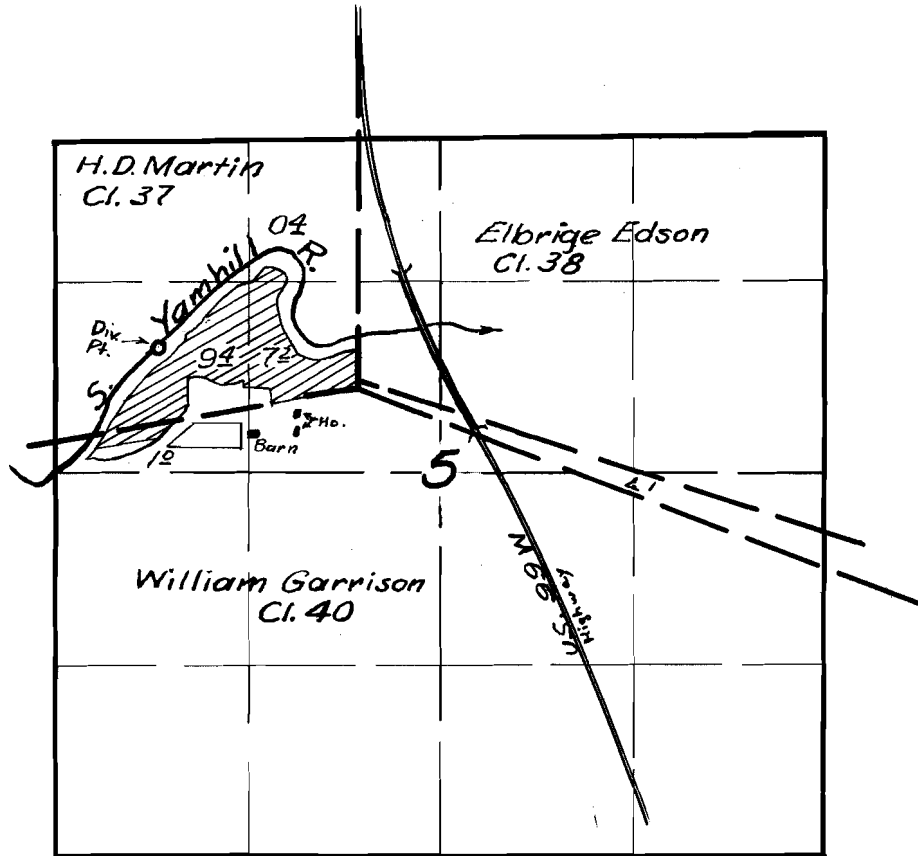

FINAL PROOF SURVEY

UNDER

Application No. 27827 Permit No. 21888

IN NAME OF

M. Swartzentruber

Surveyed Mar. 15 1956, by M. A. Bish