


T. 10 S., R. 40 E., W.M.

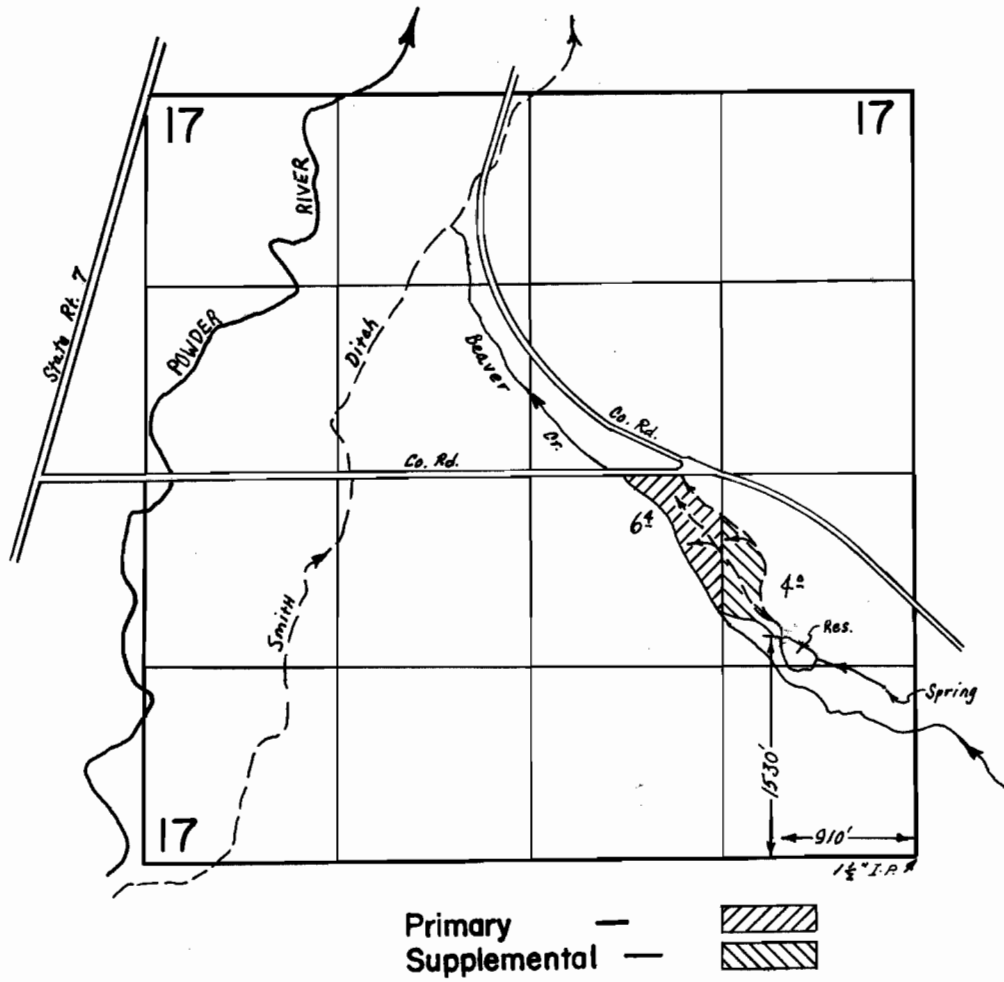

FINAL PROOF SURVEY UNDER

Application No. 41661 Permit No. 31089

IN NAME OF

Wilma Bennehoff

Surveyed Oct. 19 1972, by R.G. Mucken