


T.13S., R.5W., W.M.

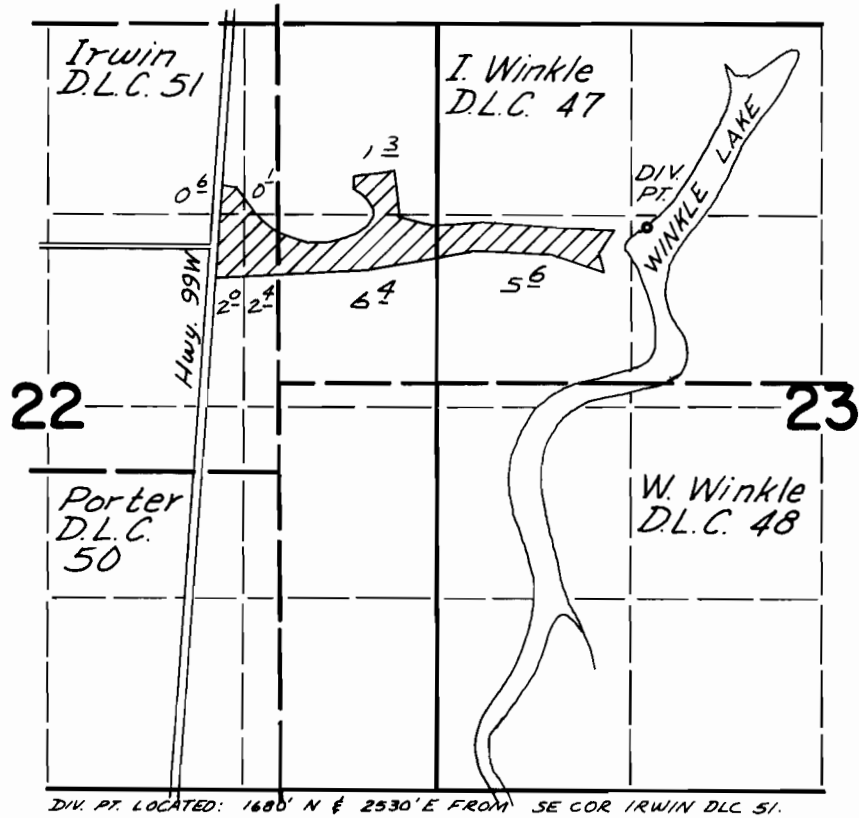

FINAL PROOF SURVEY
UNDER

Application No. 46857 Permit No. 35034
IN NAME OF

LON JENSEN

Surveyed APR 2 1973, by D. NORBY