


T. 28 & 29 S. R. 14 & 15 W. W.M.

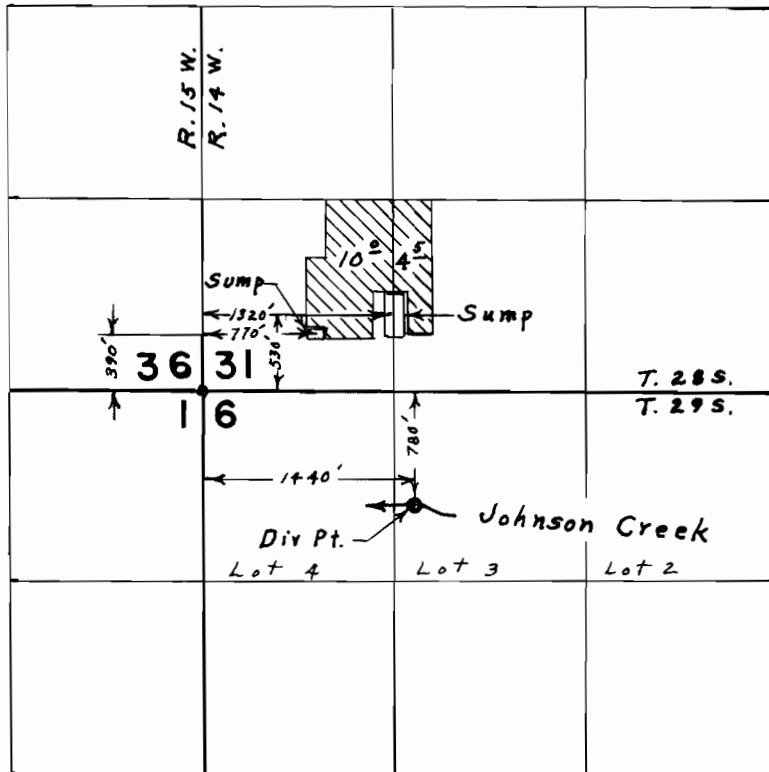

**FINAL PROOF SURVEY**  
UNDER

G-3380                      G-3233  
Application No. 41877 Permit No. 31331  
IN NAME OF

NORTON & DEAN

Surveyed April 12, 1972, by L. E. Gould.