


T. 28 & 29 S. R. 14 & 15 W. W.M.

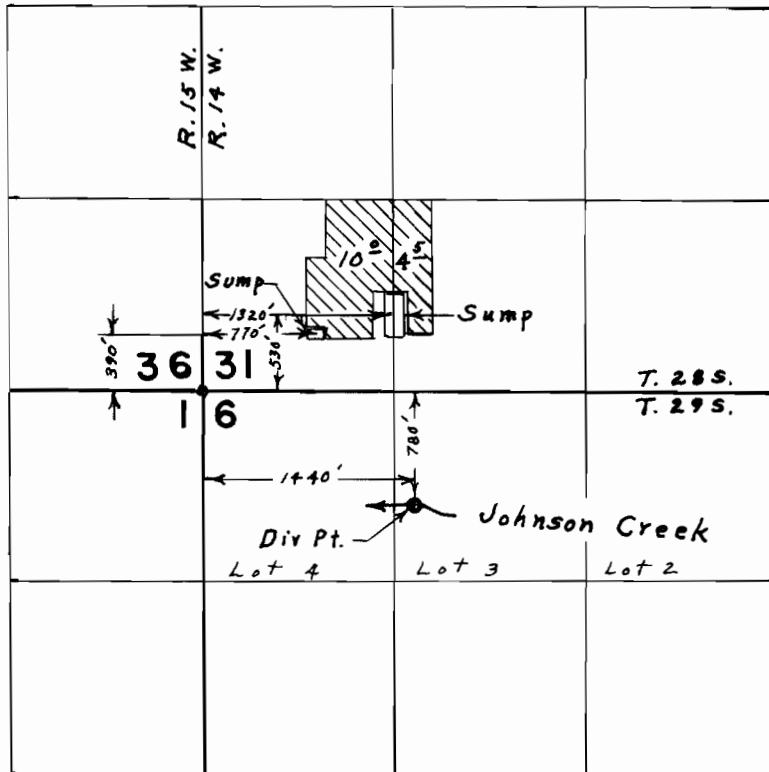

FINAL PROOF SURVEY
UNDER

Application No. 41877 Permit No. 31331
IN NAME OF

NORTON & DEAN

Surveyed April 12, 1972, by L. E. Gould