


# T.24S.R.IIW.W.M.

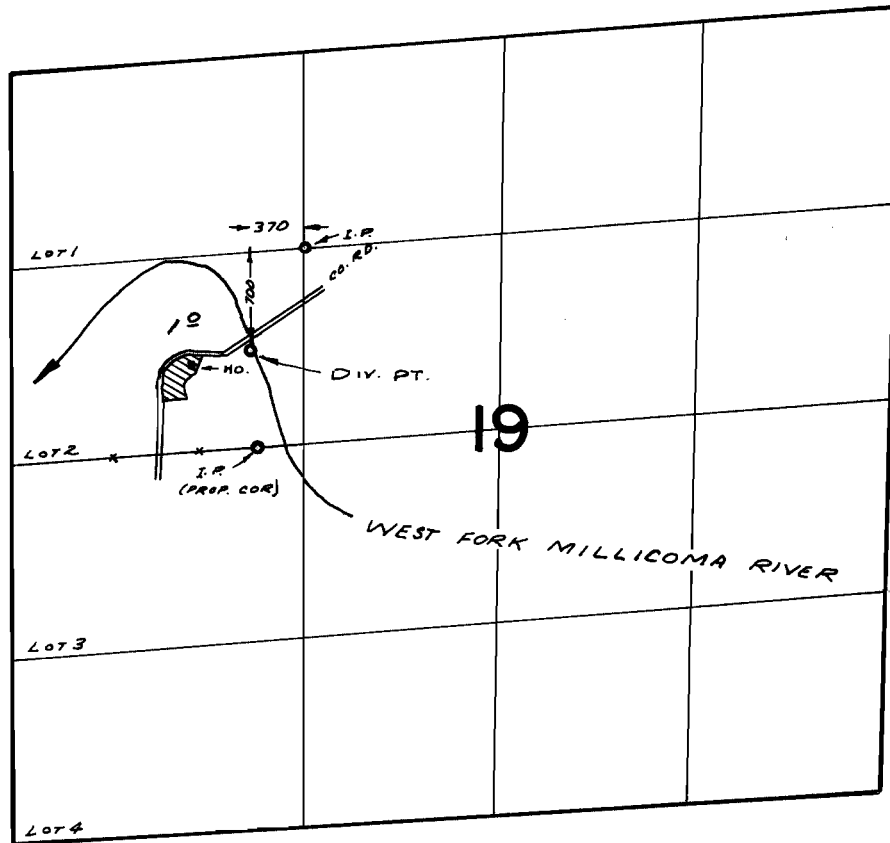

## FINAL PROOF SURVEY UNDER

Application No. 41089 Permit No. 30608  
IN NAME OF

ROGER M. FLANAGAN

Surveyed AUG. 2, 1972, by R. MUCKEN