


T.27S., R.12W., W.M.

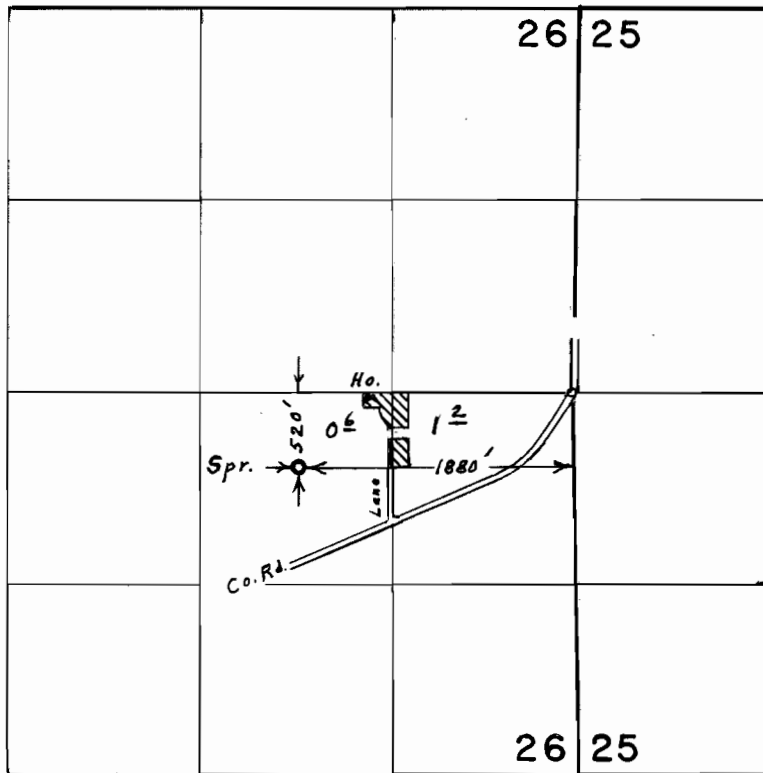

**FINAL PROOF SURVEY**  
UNDER

Application No. 42295 Permit No. 31629  
IN NAME OF

VANCE E. OR ESTHER JOANNE KING

Surveyed July 12, 1972, by L. E. Gould