


T.29 S., R.14 W., W.M.

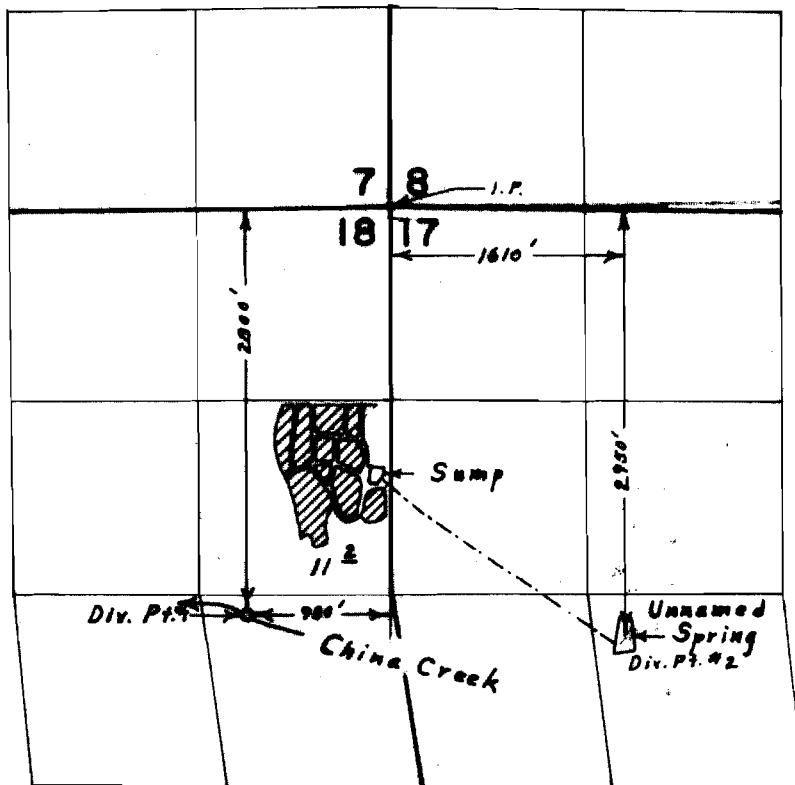

FINAL PROOF SURVEY
UNDER

Application No. 42061 Permit No. 31935
IN NAME OF

HANS C. CHRISTENSEN

Surveyed July 17, 1972, by L. E. Gould