


T. 29 S. R. 12 W. W.M.

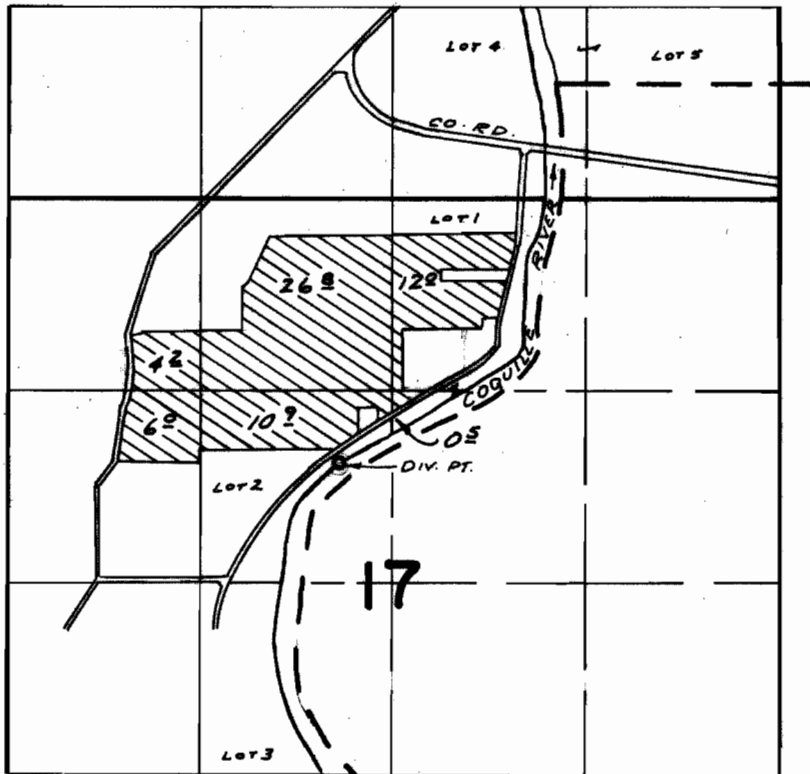

DIV. PT. LOC: 500'S. \angle 950'E. FROM N.W. COR. LOT 2 (SE $\frac{1}{4}$ NW $\frac{1}{4}$) SEC. 17

FINAL PROOF SURVEY UNDER

Application No. 45007... Permit No. 33634...
IN NAME OF

WILTON M. & JANET A. THOMAS.....

Surveyed JULY 12, 1972, by R. MUCKEN