


T.28S., R.13W., W.M.

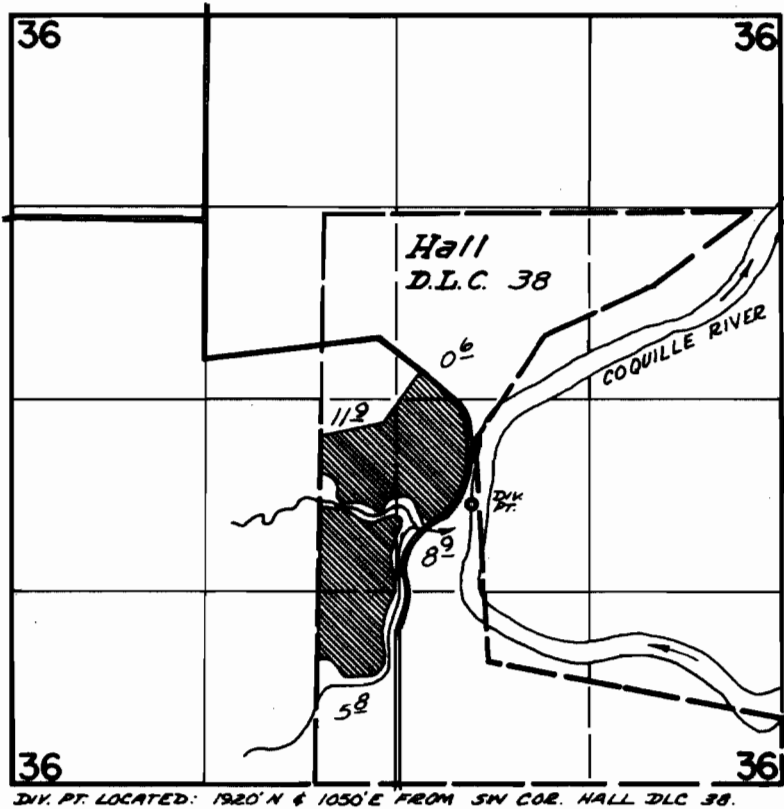

**FINAL PROOF SURVEY**  
UNDER

Application No. 43498 Permit No. 32536  
IN NAME OF

GALE D. & JANET M. ROOD

Surveyed July 20 1972, by L.E. Gould