


T.27&28S.R.14W.W.M.

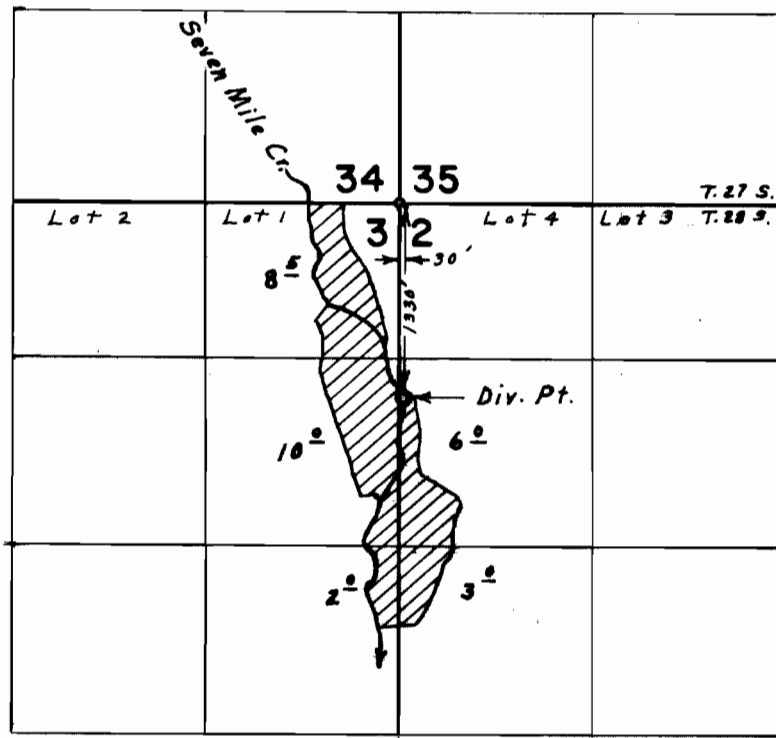

FINAL PROOF SURVEY
UNDER

Application No. 45890 Permit No. 34265
IN NAME OF

JERRY R. DAUGHERTY

Surveyed April 14, 1972, by L. E. Gould