


# T. 28 & 29 S. R. 14 & 15 W. W.M.

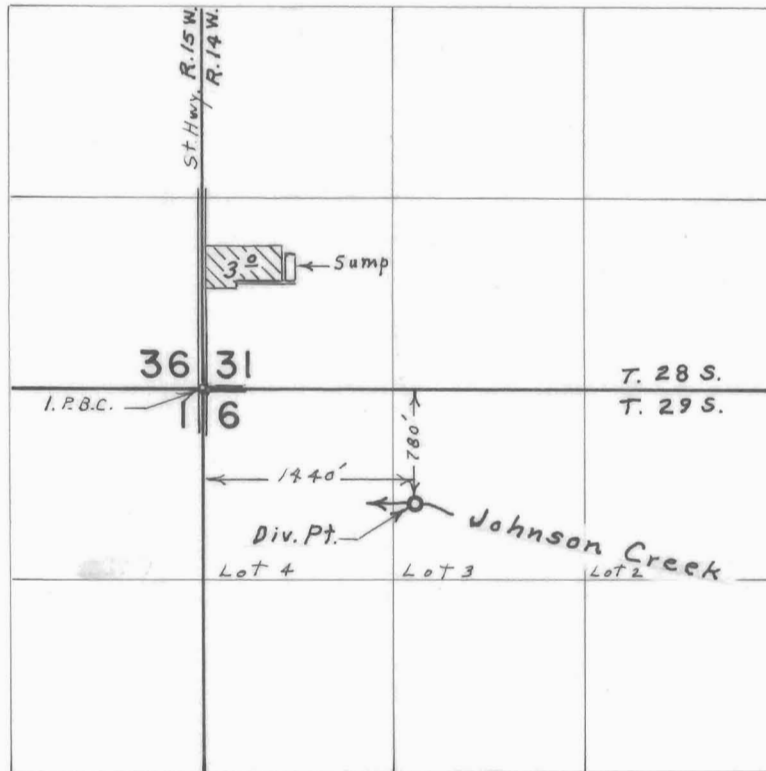

## FINAL PROOF SURVEY UNDER

Application No. 46835 Permit No. 35130  
IN NAME OF

JOHN A. McMAHON

Surveyed April 12, 1972, by L. E. Gould