


T. 30S. R. 15W. W.M.

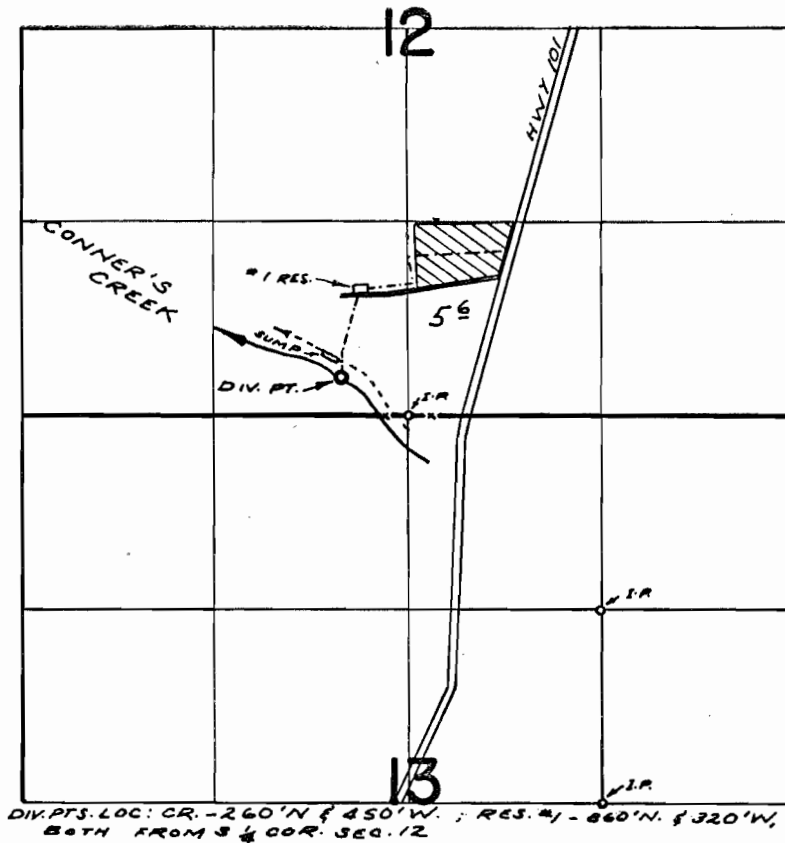

FINAL PROOF SURVEY UNDER

Application No. R-43654 Permit No. R-5014
R-43655 32634
IN NAME OF

MELVIN RAYMOND

Surveyed AUG. 10, 1972, by R. MUCKEN