


T. 30S. R. 15W. W.M.

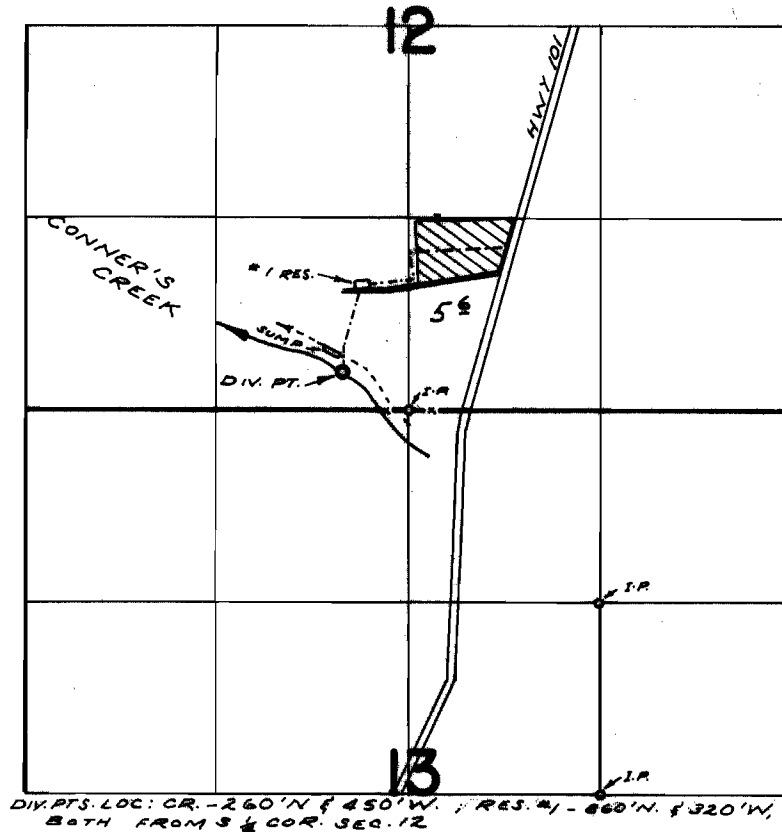

**FINAL PROOF SURVEY**  
UNDER

Application No. R-43654 Permit No. R-5014  
R-43655 32634  
IN NAME OF

MELVIN RAYMOND

Surveyed AUG. 10, 1972, by R. MUCKEN