


T.26S., R.6&7W., W.M.

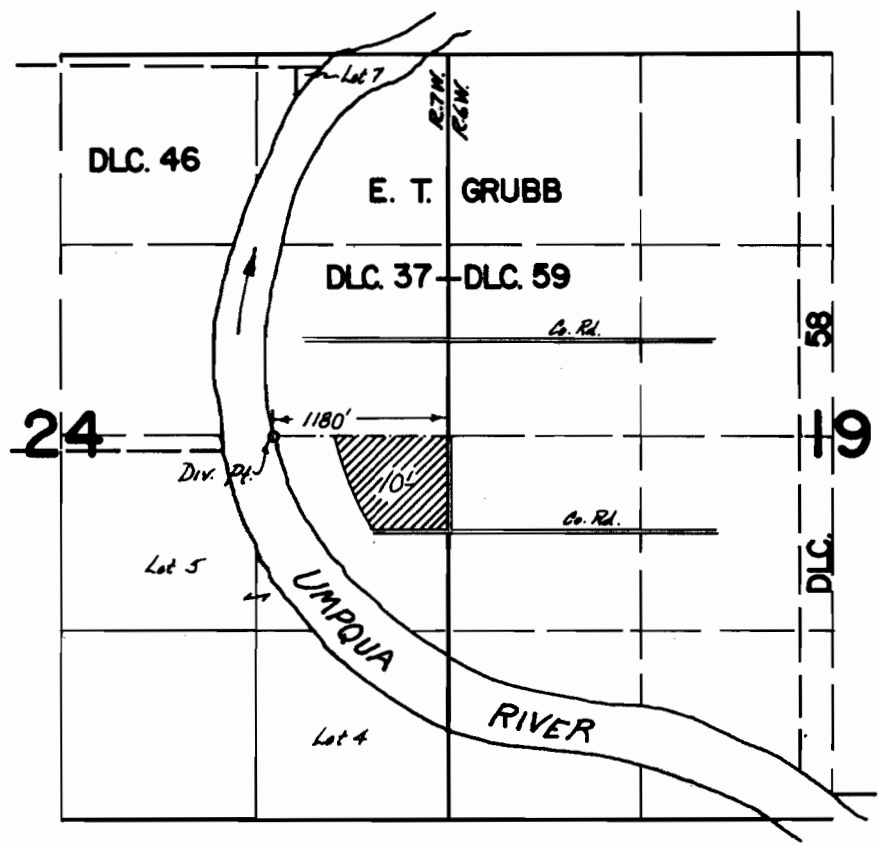

FINAL PROOF SURVEY UNDER

Application No. 45116 Permit No. 33712
IN NAME OF

J. CLIFFORD HESS

Surveyed 3 MAY 1972, by D. NORBY