


T. 22 S., R. 5 W., W.M.

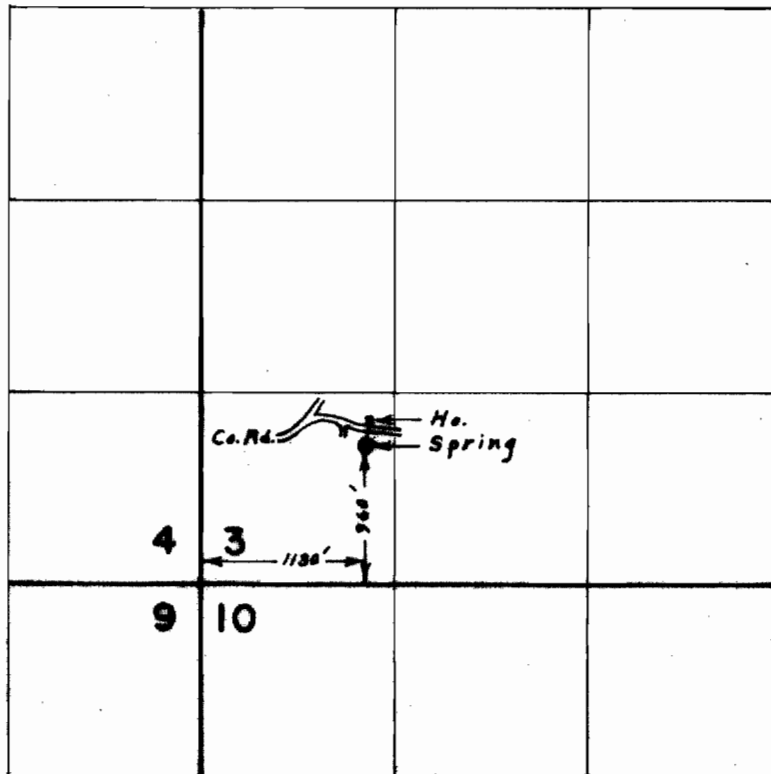

FINAL PROOF SURVEY
UNDER

Application No. 45867 Permit No. 34244
IN NAME OF

WILDA G. WILSON

Surveyed May 12, 1972, by L. E. Gould