


T. 29S., R. 7W., W.M.

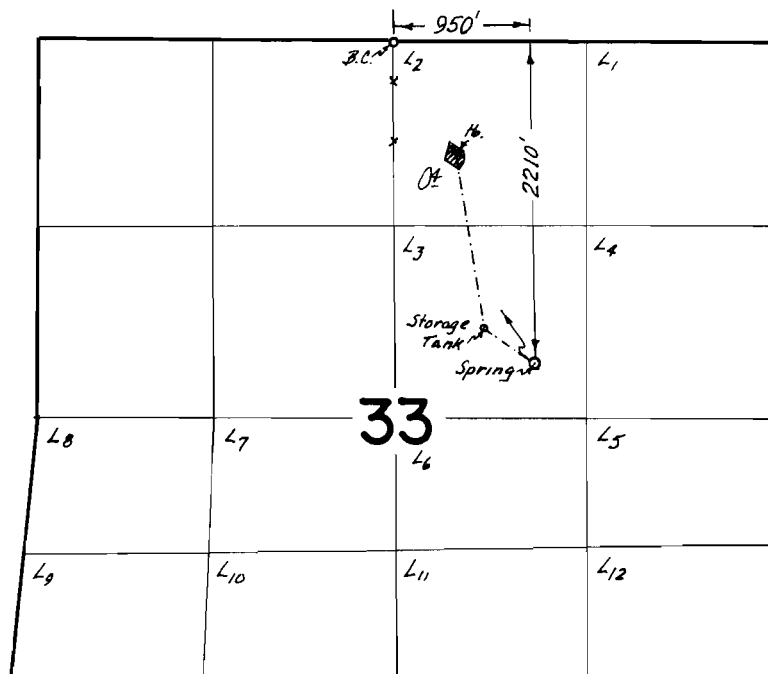

FINAL PROOF SURVEY
UNDER

Application No. 46267 Permit No. 34566
IN NAME OF

EVANGELINE BAKER

Surveyed 8 MAY 19 72, by D. NORBY