


T.25S., R.7W., W.M.

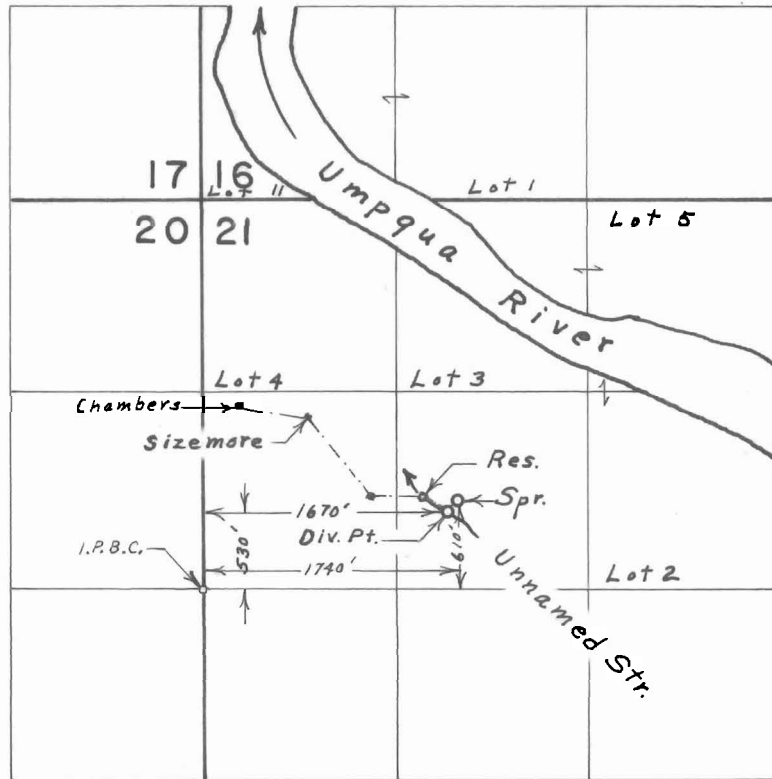

FINAL PROOF SURVEY
UNDER

Application No. 46860 Permit No. 35037
IN NAME OF

GILBERT D. SIZEMORE

Surveyed May 2, 1972, by L. E. Gould