


G-2594

39637 6

T.13S., R.31E., W.M.

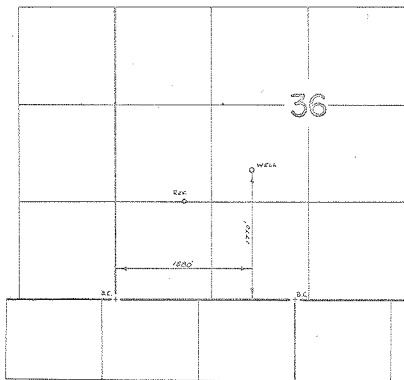


FINAL PROOF SURVEY
UNDER

Application No. G-2720 Permit No. G-2594
IN NAME OF

CITY OF CANYON CITY

Surveyed Aug 10 1972, by D. Herby

C-27627

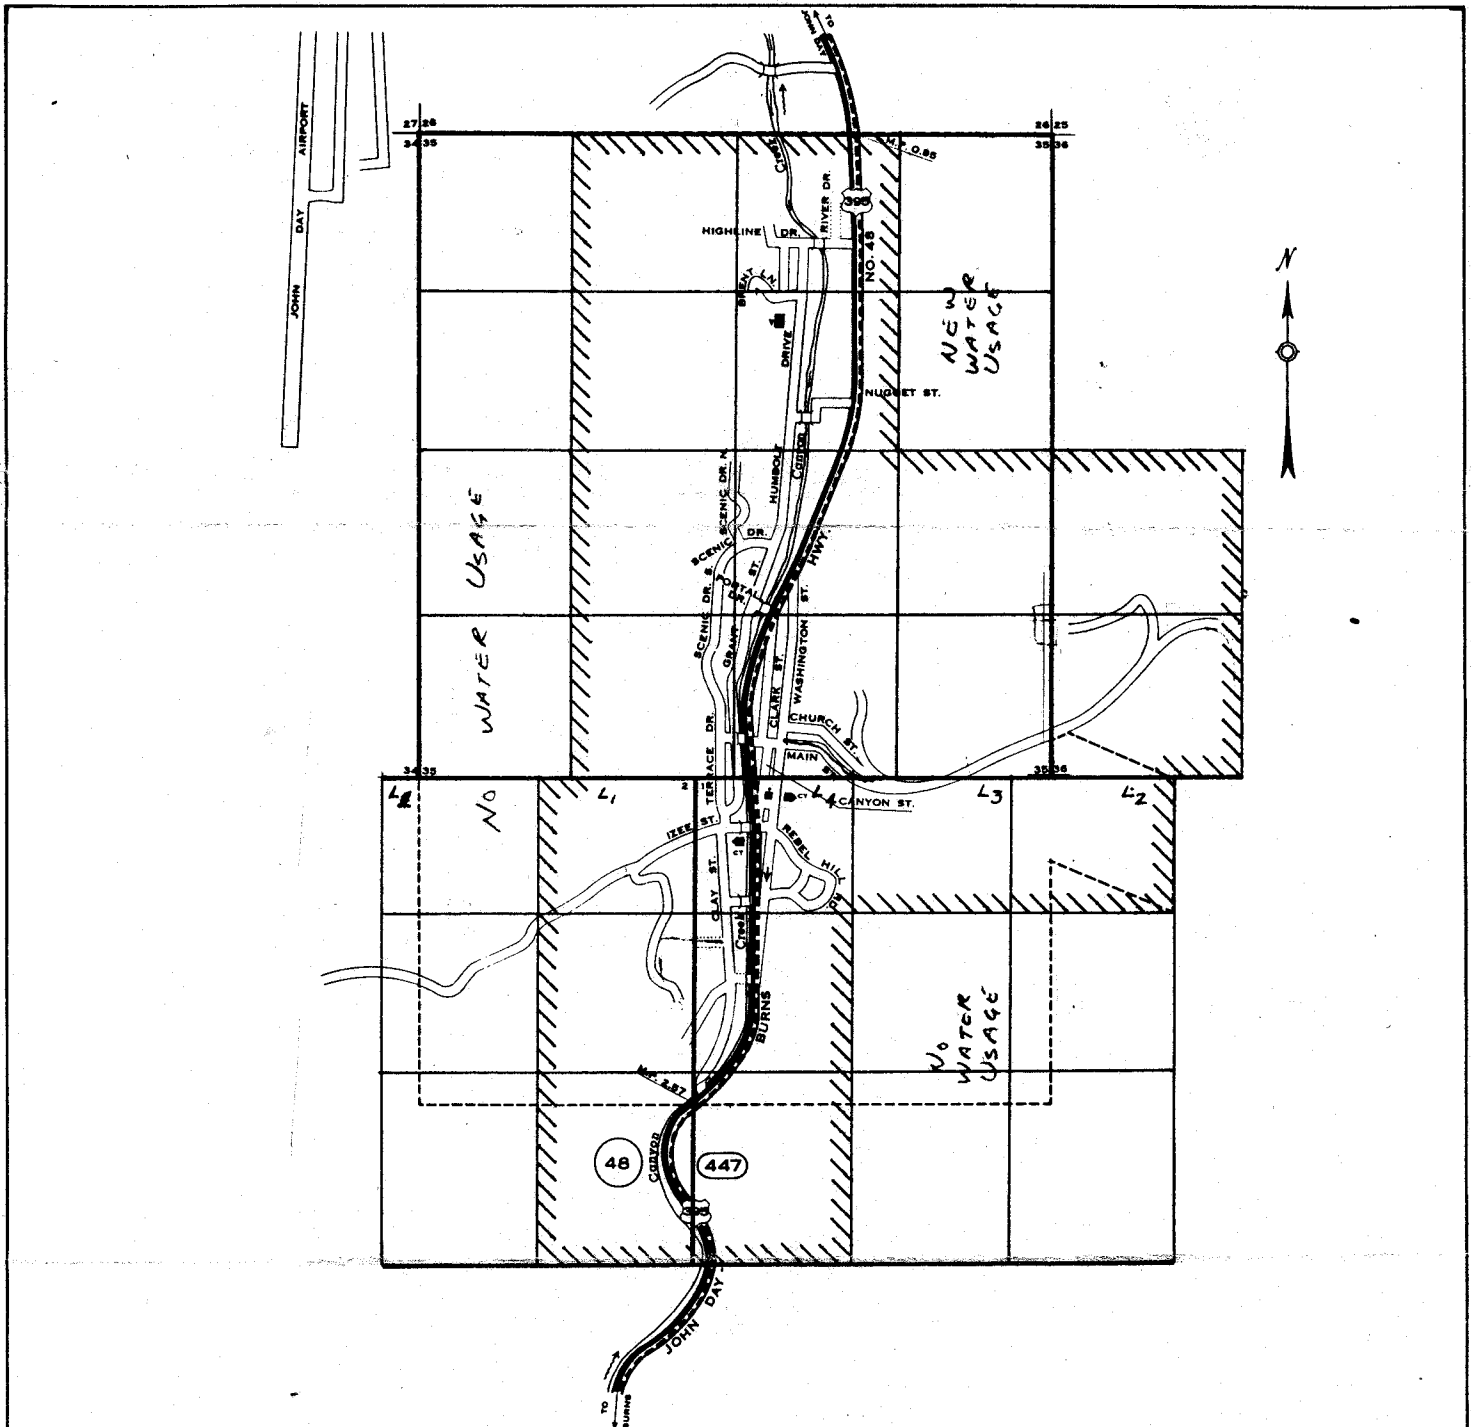

HIGHWAY CLASSIFICATION

	State (Red)	Federal (Green)
PRIMARY		
SECONDARY		
OTHER		

SIGNED ROUTES

INTERSTATE	
U.S.	
ORE.	

LEGEND

- Post Office
- School
- R. R. Depot
- Public Bldg.
- City Hall
- Court House
- Armory
- Library
- Street open for travel.
- Street dedicated but not open.
- City Limits.

CANYON CITY
GRANT COUNTY, OREGON

PREPARED BY THE
OREGON STATE HIGHWAY DEPARTMENT

IN COOPERATION WITH THE
U.S. DEPARTMENT OF COMMERCE
BUREAU OF PUBLIC ROADS

Population 630

Scale in Feet
0 100 200 300

Revised July 1966