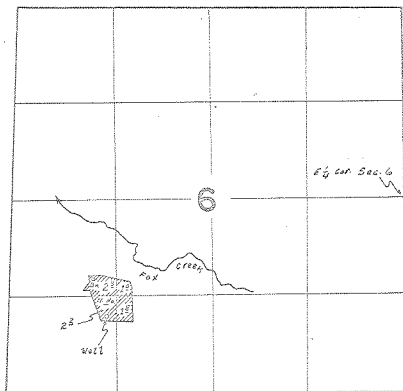


G-3477

396386

T. 11S. R. 30E. W.M.

Well Sec. 1880 S. & 4100 W. from E $\frac{1}{2}$ cor. Sec. 6

FINAL PROOF SURVEY UNDER

Application No. G-3687 Permit No. G-3491
IN NAME OF
Max Justice

Surveyed 10 Aug. 1972, by L. E. Gault

C-39638

1972-T-280