


T. 11S. R. 29E. W.M.

G-3499

39639 C

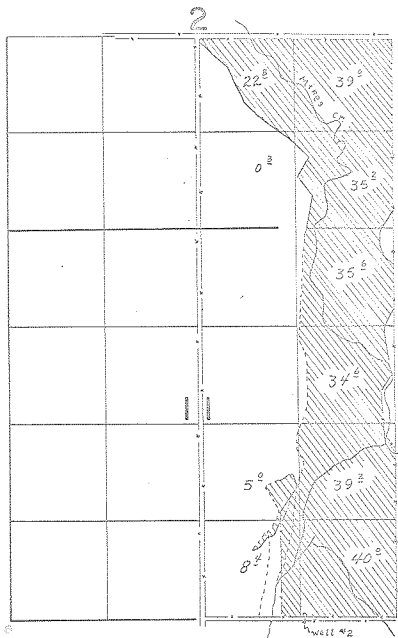

Well Loc. 20' N. & 1260' W. from SW. Cor. Sec. 21

FINAL PROOF SURVEY
UNDER

Application No. G-3496 Permit No. Q-3499
IN NAME OF
Savilla Trowbridge

Surveyed 10 Aug. 1972, by L.E. Gould

G-39639

Adjudication Map 1972, T. 11S.