


T.11S. R.30E. W.M.

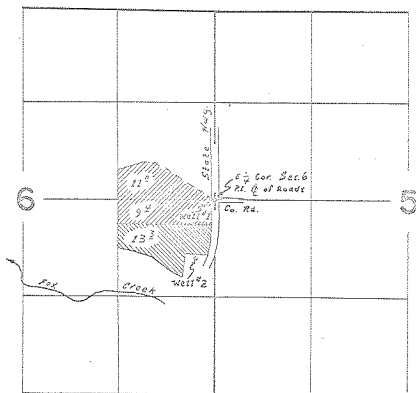

Well #1 60'S. 130°W. } All loc. from E. 1/4 Cor. Sec. 6
 Well #2 800'S. 1260°W. }

FINAL PROOF SURVEY UNDER

Application No. G-3808 Permit No. G-3593
 IN NAME OF
F. B. McGirr

Surveyed 10 Aug. 1972, by L. E. Gould