


T.14S.R.32E.W.M.

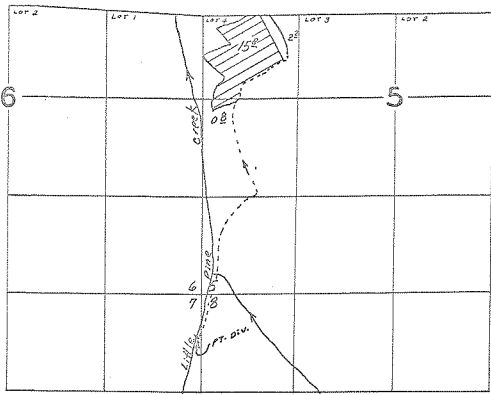

FINAL PROOF SURVEY UNDER

Application No. 37680. Permit No. 28083..
IN NAME OF

Carl Sheedy

Surveyed Aug. 16, 1965, by G. Ward

39642

4-1965-B.