


P 29058
39644

6

T.13S., R.33E., W.M.

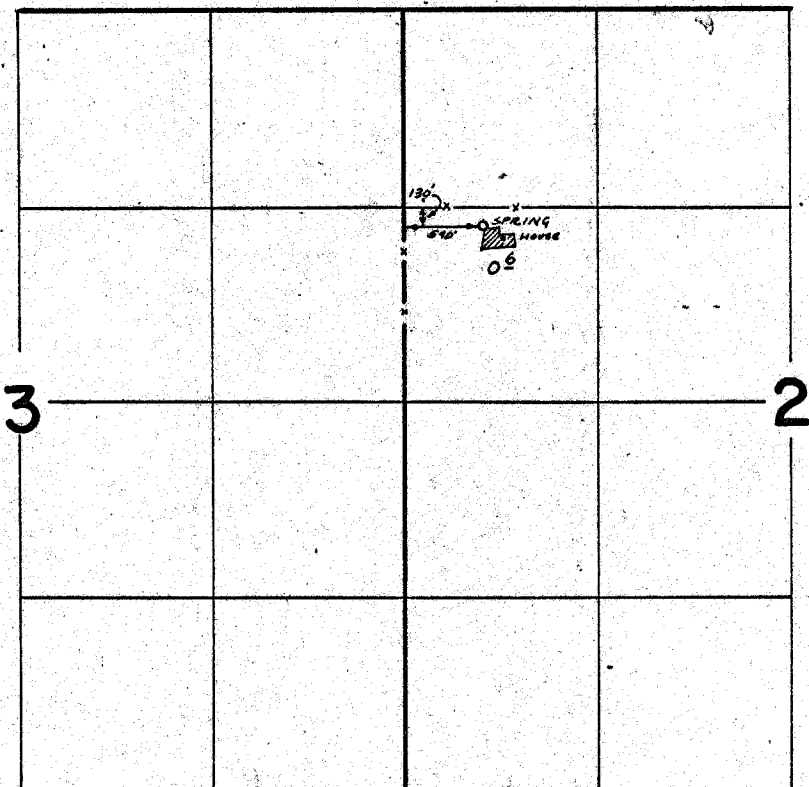

FINAL PROOF SURVEY UNDER

Application No. 39011 Permit No. 29058
IN NAME OF

KARL A. VOIGT

Surveyed Aug 2 1972, by D. Norby

C-39644