


T.13&14S., R.32E., W.M.

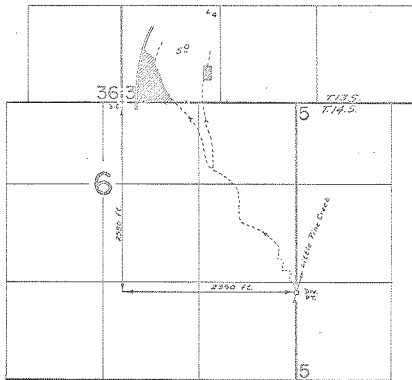

FINAL PROOF SURVEY
UNDER

Application No. 39412 Permit No. 29511
IN NAME OF

CARL & BETTY JANE SHEEDY

Surveyed July 17 1972, by D. Norby