


T.14S., R.34E., W.M.

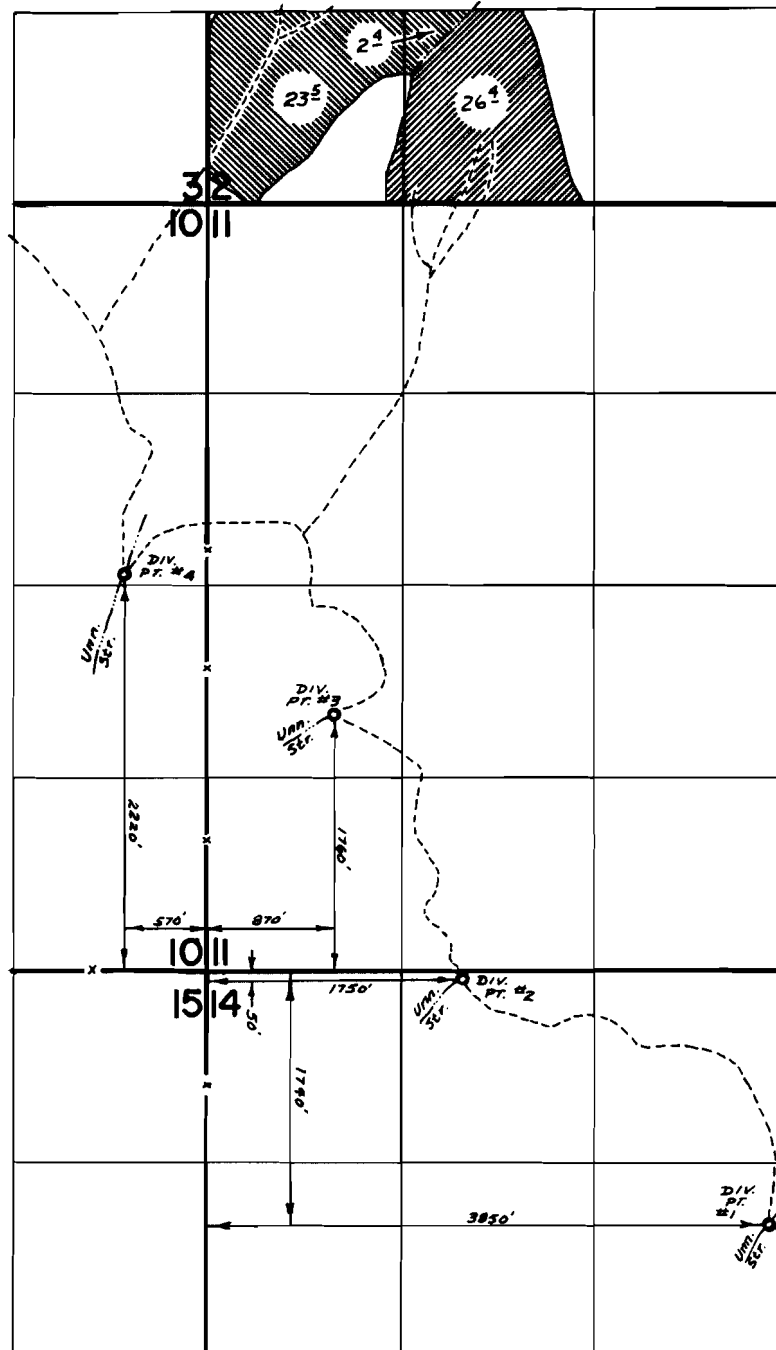

FROM DIV. PTS.
#1, 2, 3, & 4

FROM DIV. PTS.
#1, 2, & 3

FINAL PROOF SURVEY UNDER

Application No. 40726 Permit No. 30378
IN NAME OF

ERVING STANBRO

Surveyed Aug 4 1972, by D. Norby