


# T.13 S., R.31 E., W.M.

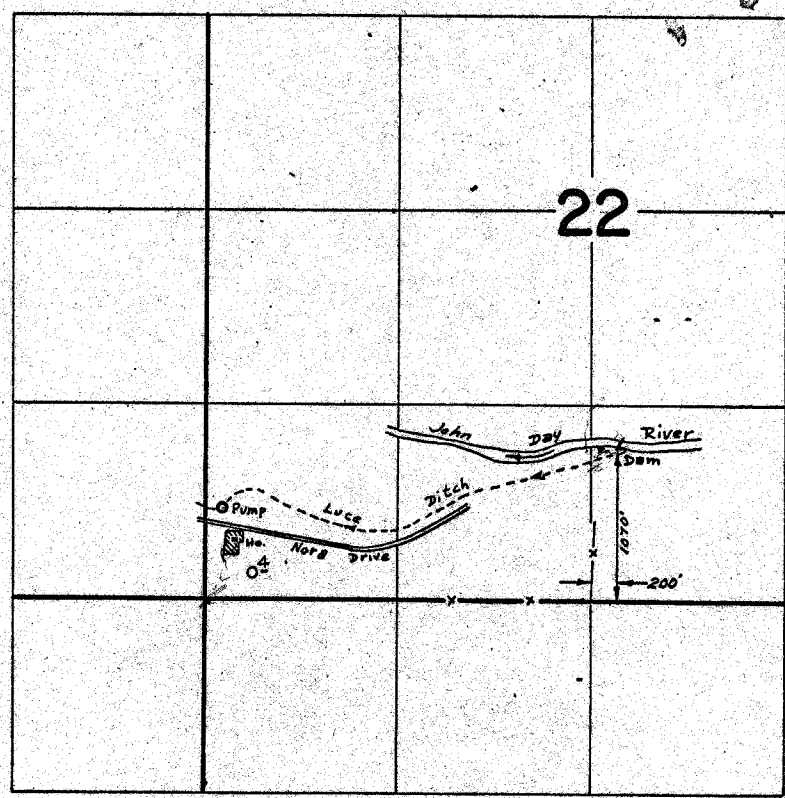

## FINAL PROOF SURVEY UNDER

Application No. 40978 Permit No. 30557  
IN NAME OF

H. T. GRIMSLEY

Surveyed July 11 1972, by D. Norby

C-39647