


# T.13S., R.29E., W.M.

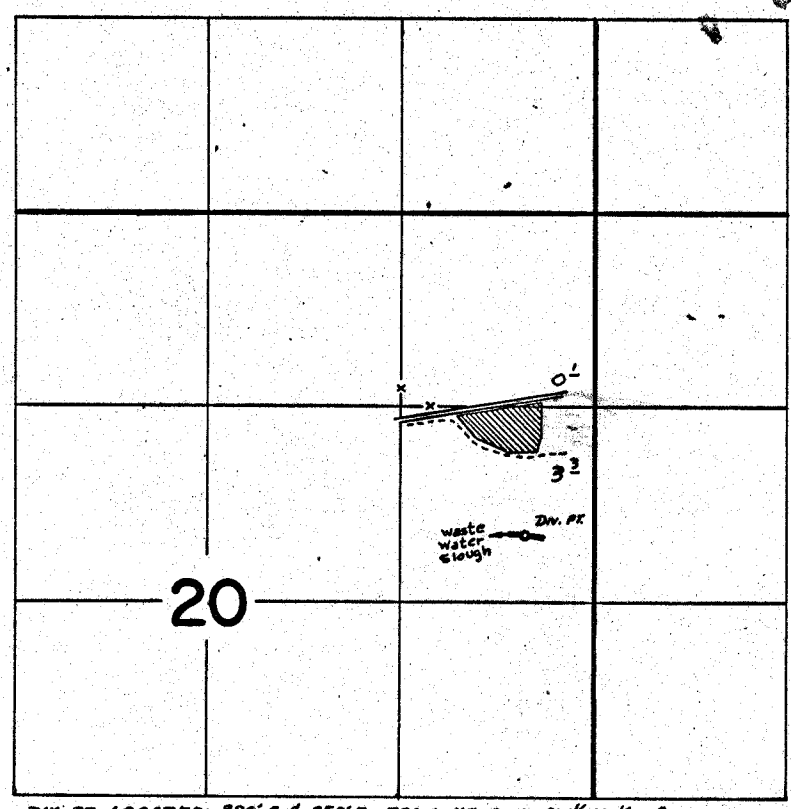

DIK. PT. LOCATED: 880'S & 850'E FROM NE COR SW 1/4 NE 1/4 SEC 20

## FINAL PROOF SURVEY UNDER

Application No. 41776 Permit No. 31180  
IN NAME OF

ELMER JOHNSON

Surveyed July 12 1972, by D. Norby