


T.13S., R.34E., W.M.

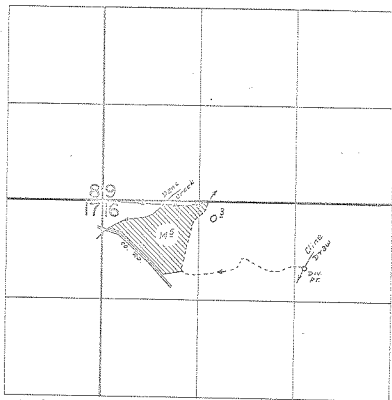

DIP. PT. LOCATED: S60°3' E 2786'E FROM NW COR. SEC. 16.

FINAL PROOF SURVEY UNDER

Application No. 13101 Permit No. 32285
IN NAME OF

HARVEY D. FIELD

Surveyed Aug. 7 1972, by D. Warby