


34705 4
39658

T. 8 S. R. 29 & 30 E. W. M.

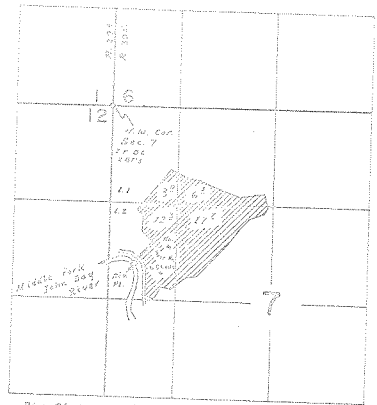

Div. Pl. Sec. 21° 40' 00" & 350' from N.W. Cor. Sec. 7

FINAL PROOF SURVEY
UNDER

Application No. 46 852 Permit No. 34705
IN NAME OF
Fred B. & Jacqueline Burnette

Surveyed 4 Aug. 1972, by L.F. Gould

C-39658