


35460
C-39659

T.13S., R.31E., W.M.

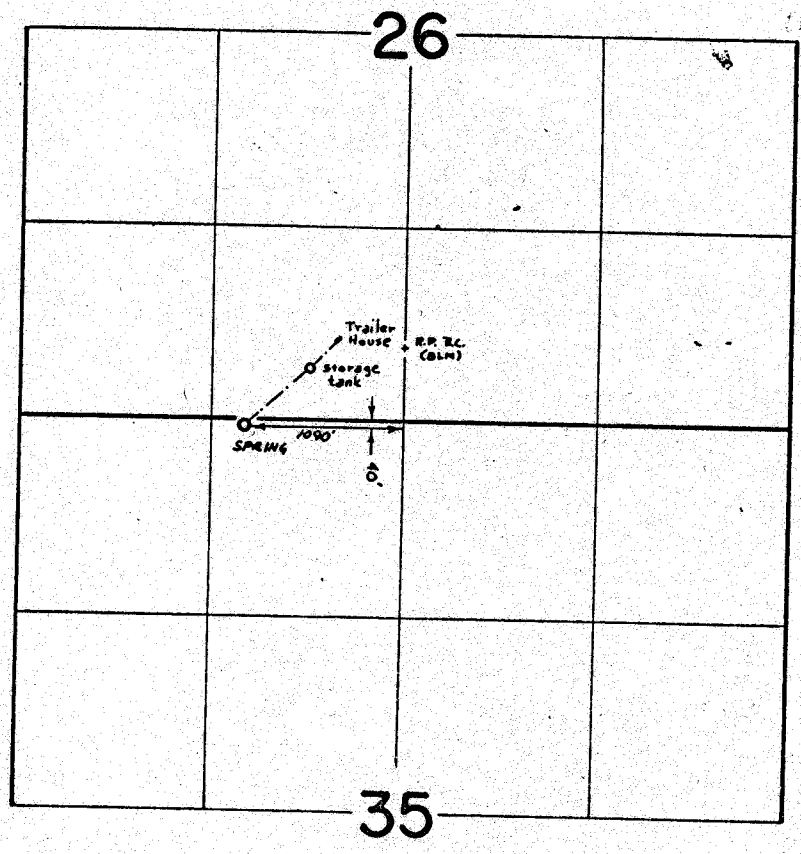

FINAL PROOF SURVEY
UNDER

Application No. 47336 Permit No. 35460
IN NAME OF
ROYEL ALLEN

Surveyed Aug. 9 1972, by D. Norby

C-39659