


T. 23 S. R. 30 & 31 E. W.M.

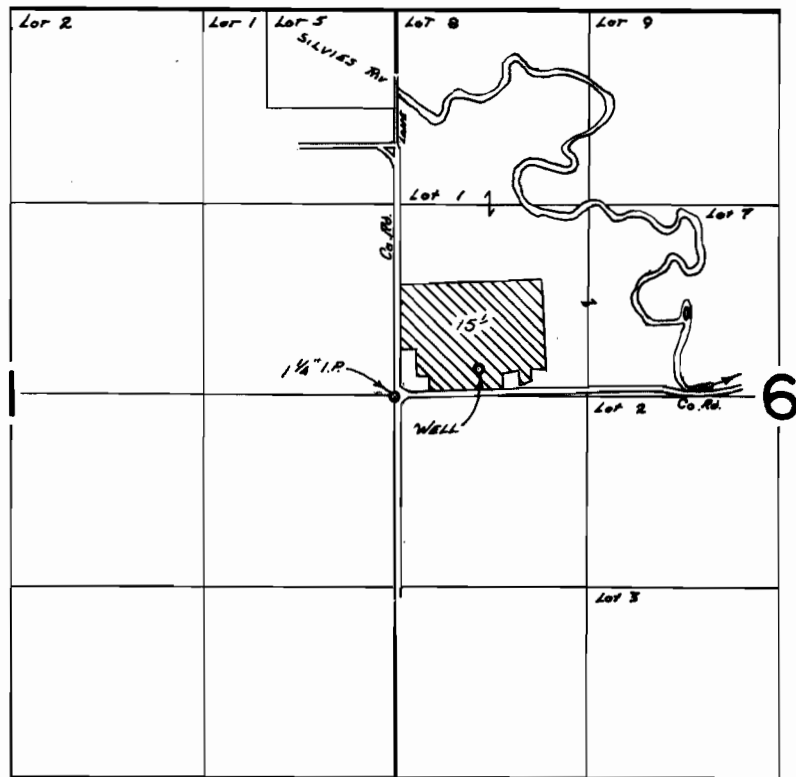

WELL Loc: 180' N & 580' E FROM W. 1/4 COR SEC. 6

FINAL PROOF SURVEY
UNDER

Application No. 6-3582 Permit No. 6-3372
IN NAME OF

HOBERT S. TILLER

Surveyed Aug. 22 1972, by R.G. MURPHY